


TOWNSHIP 35 S, RANGE 4 W, W. M.

North

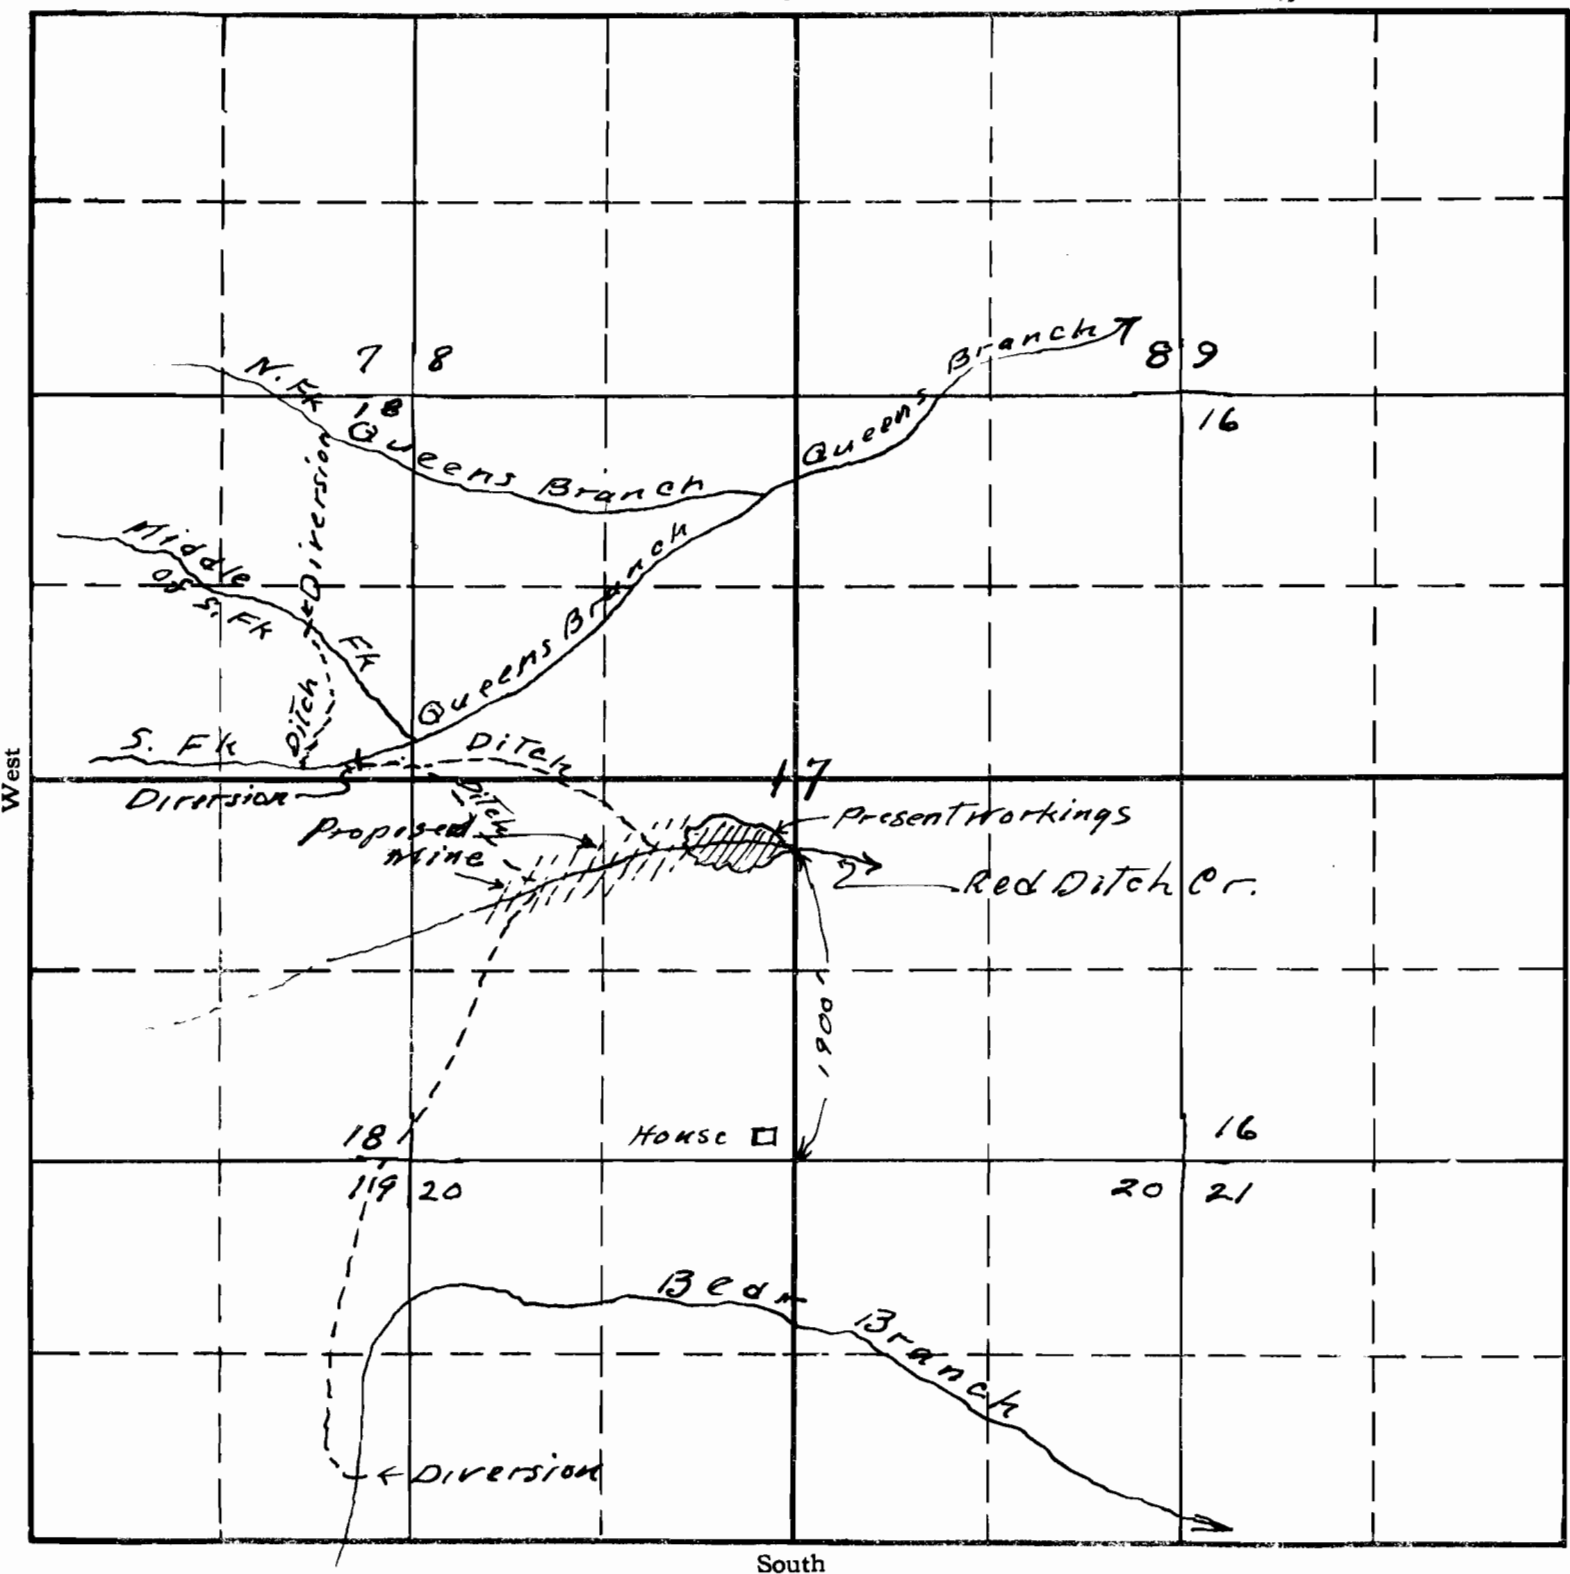


Map showing location of place of
 use in App. in name of
 Vivian Norman Barto
 Made from actual measurements and
 notes taken in the field by C A Smith
 12/6 1934

APPLICATION No. 14517
 PERMIT No. 10541

TOWNSHIP 35 S, RANGE 4 W, W. M.

North

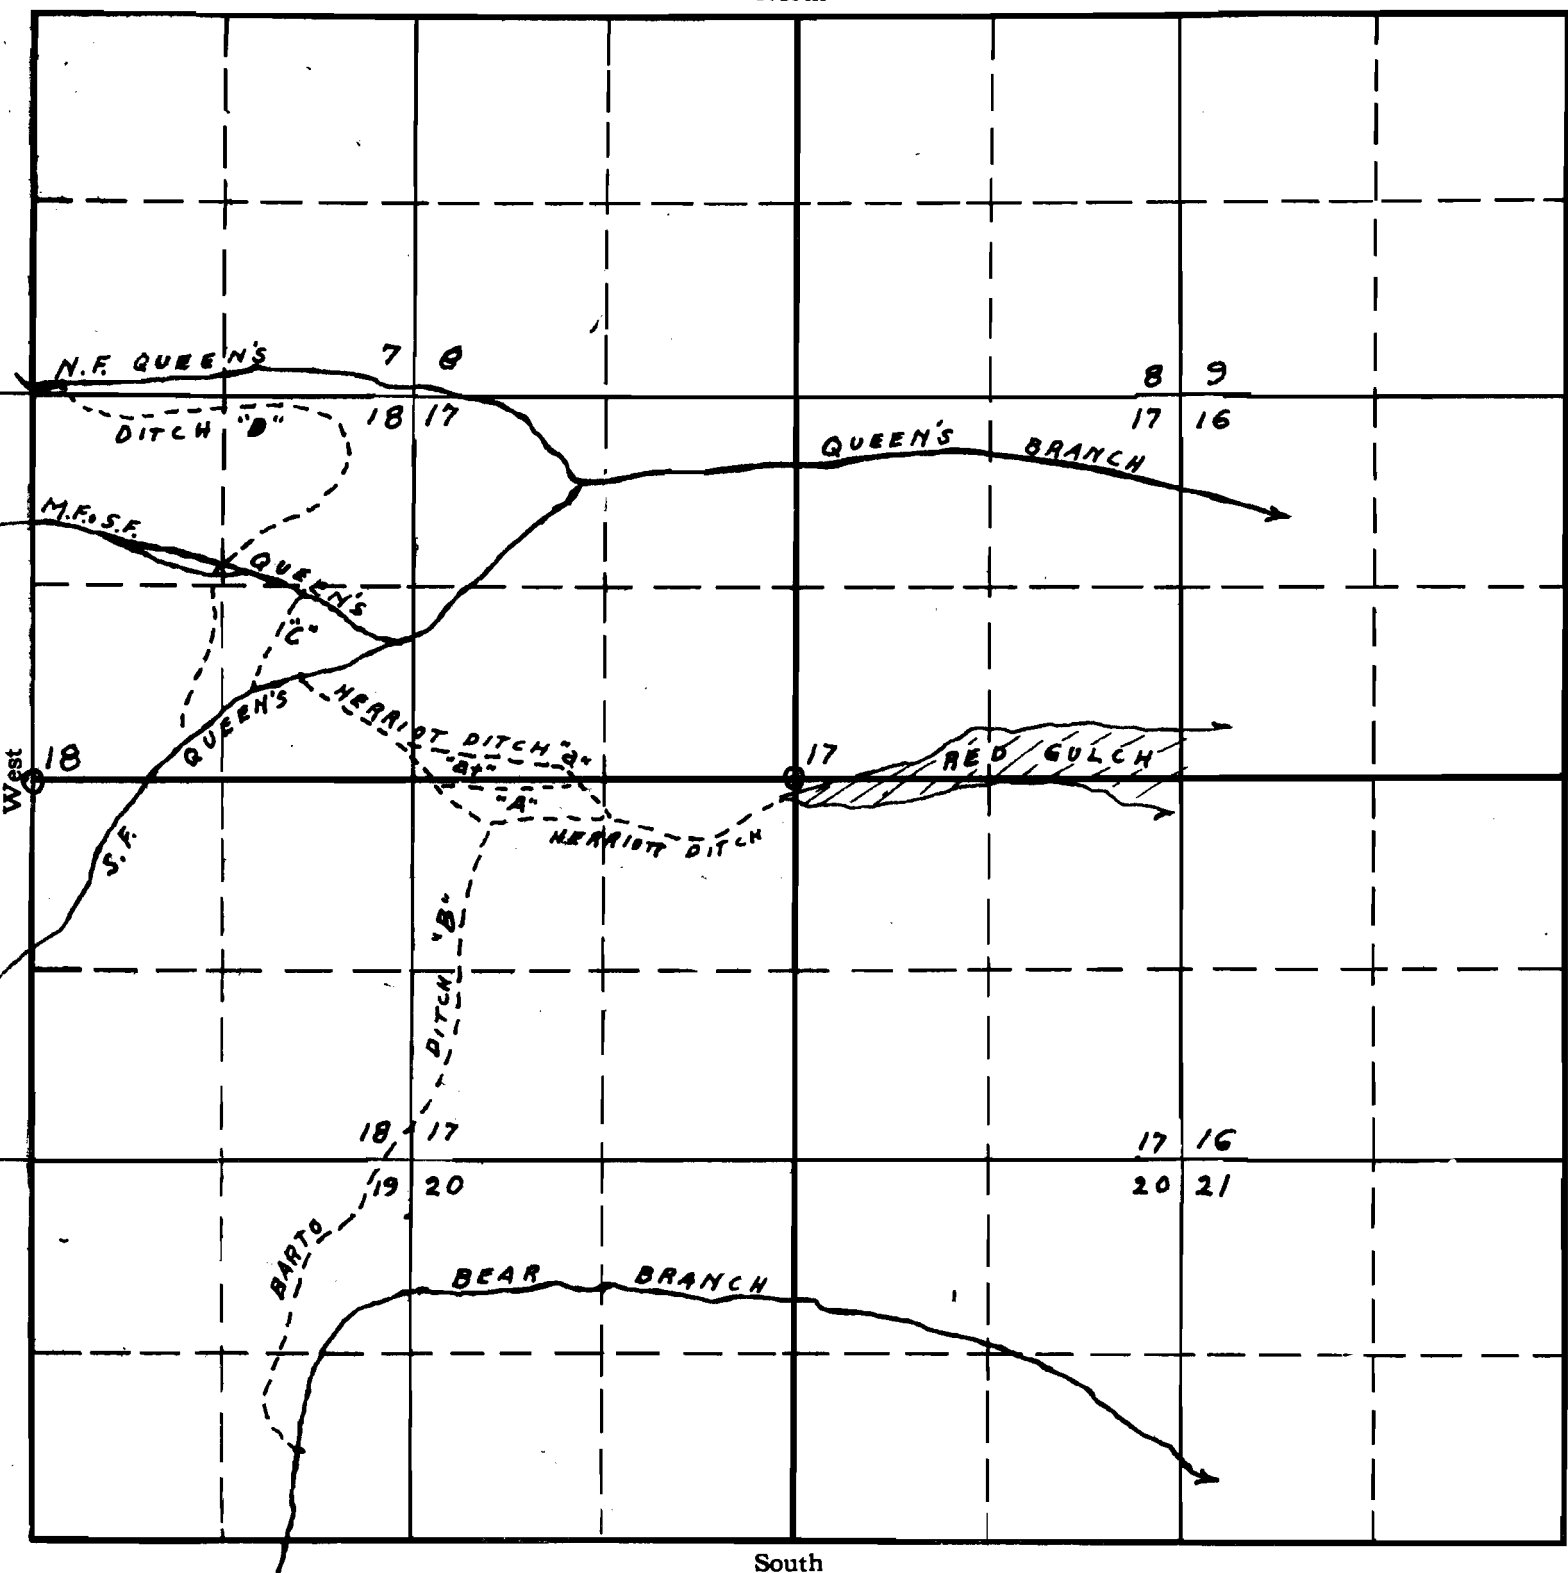

Drawn from applicant's
sketch - 4/18/32 - 18 -

APPLICATION No. 14517
PERMIT No. 10541