


10747
11013

SECTION

5

TOWNSHIP 39S, RANGE 4E, W. M.

North

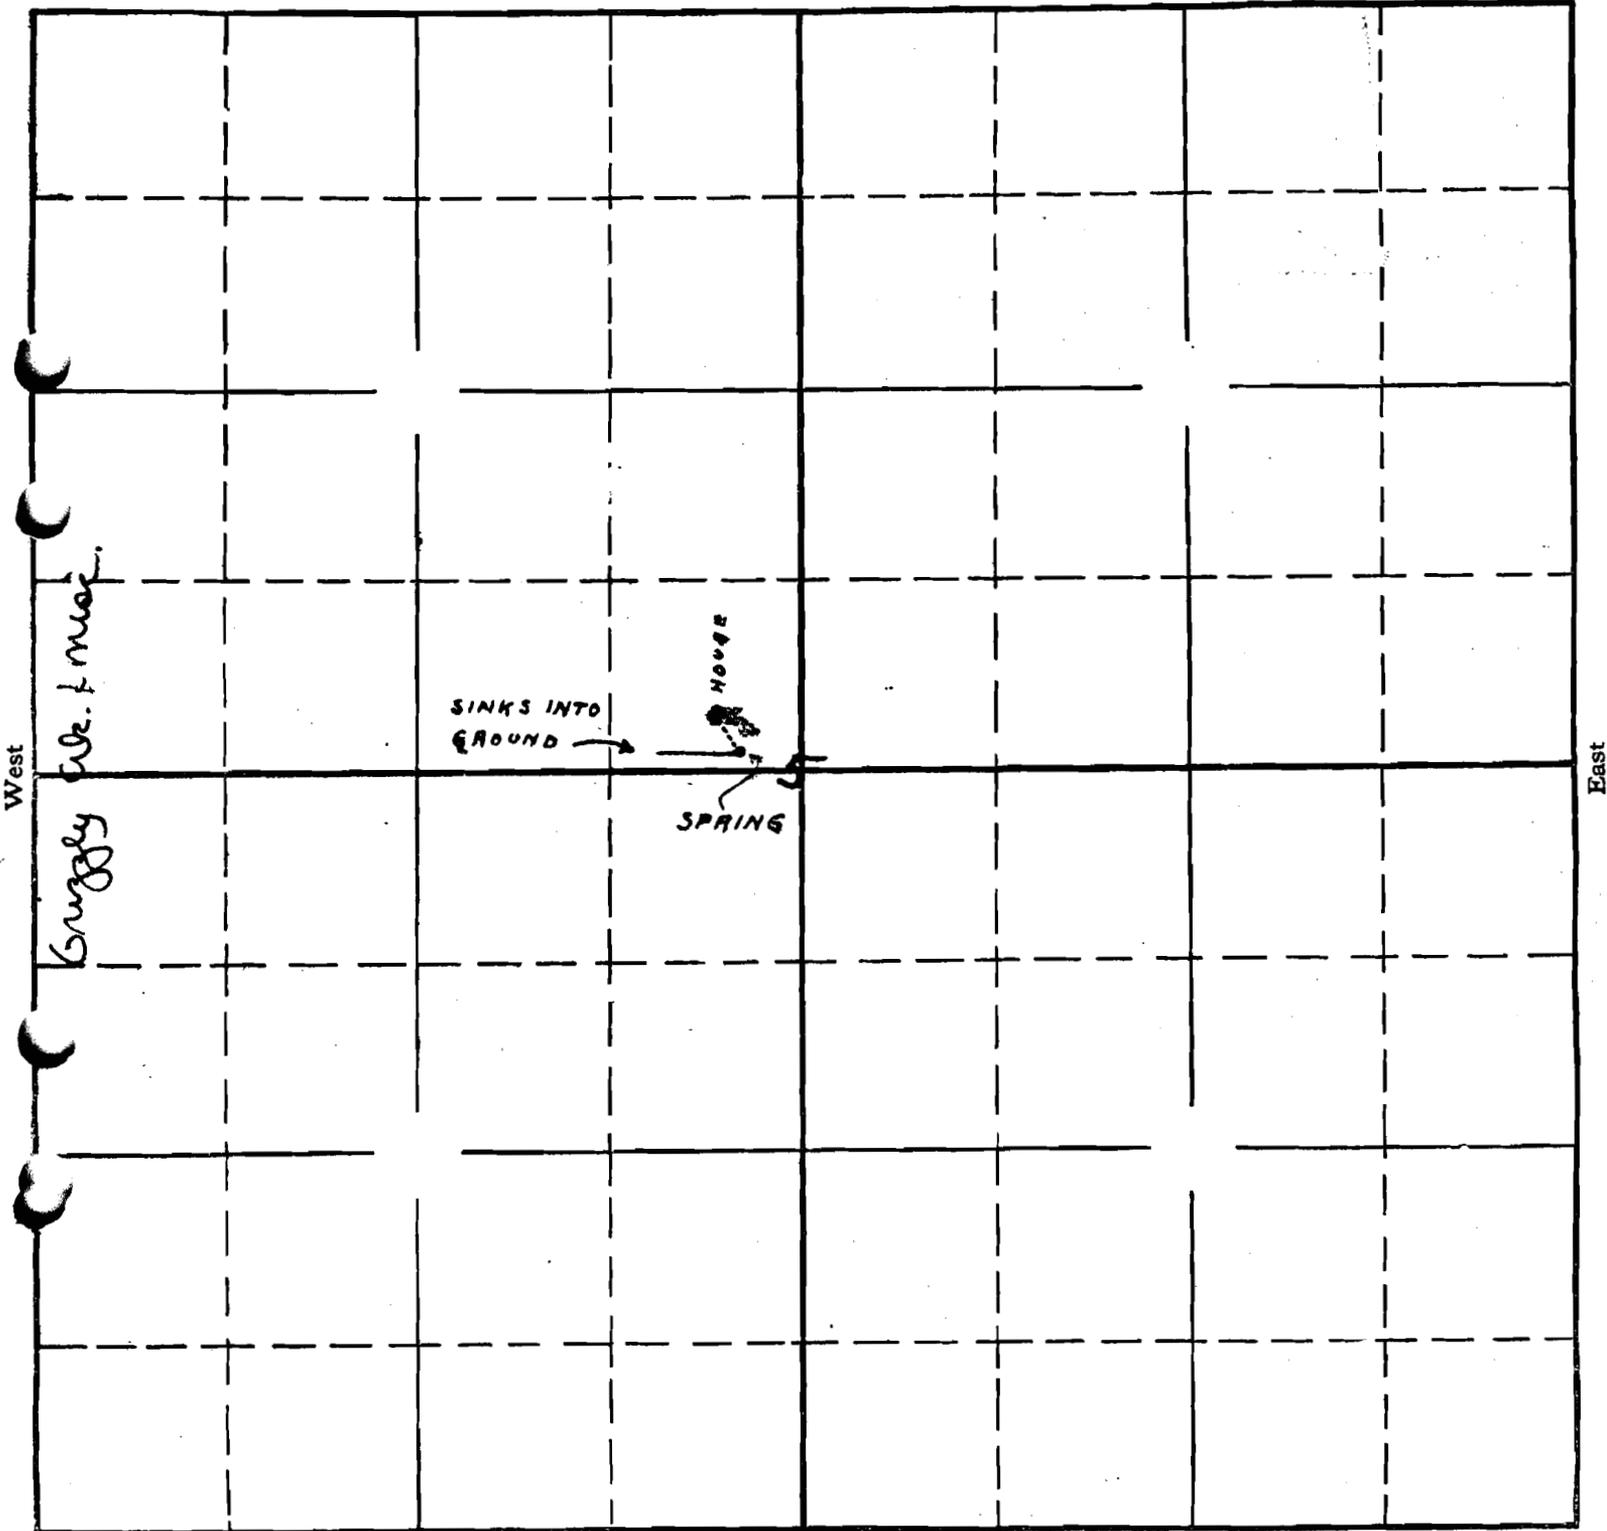

West

East

South

Copied from applicant's
sketch - 10/24/32 -

APPLICATION No. 14756
PERMIT No. 10747