


Abstract of Permit No.
T.2N.R.14E.W.M.

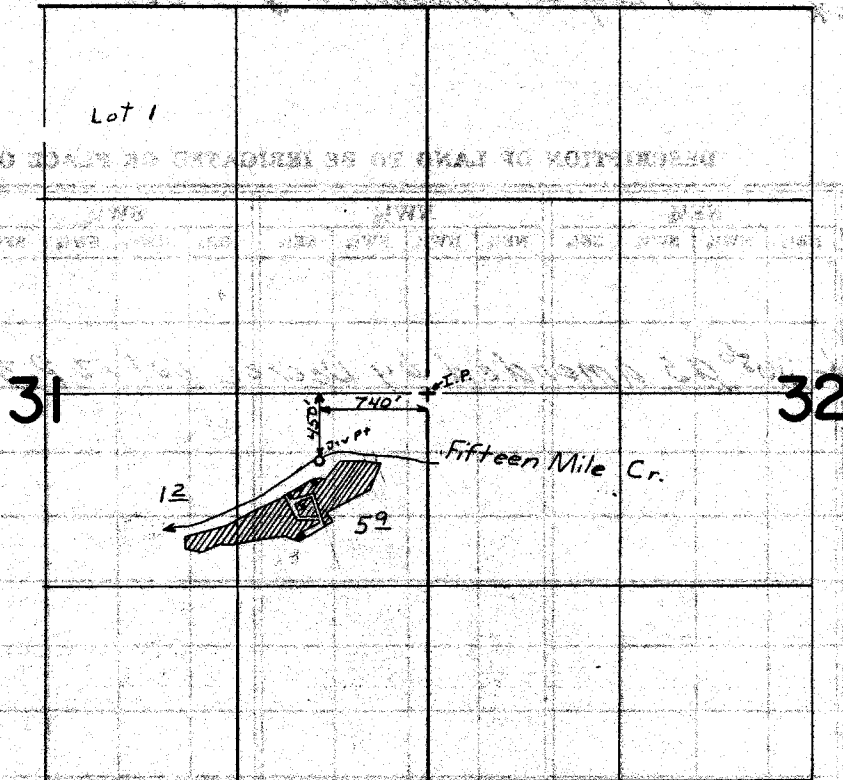

FINAL PROOF SURVEY
UNDER

Transfer No. B-139
Application No. Permit No.
IN NAME OF

Woodrow A. & Dorothy Benjamin

Surveyed June 13, 1967, by *W. H. Ruppert*