


SECTION

TOWNSHIP 25, RANGE 2E, W. M.

North

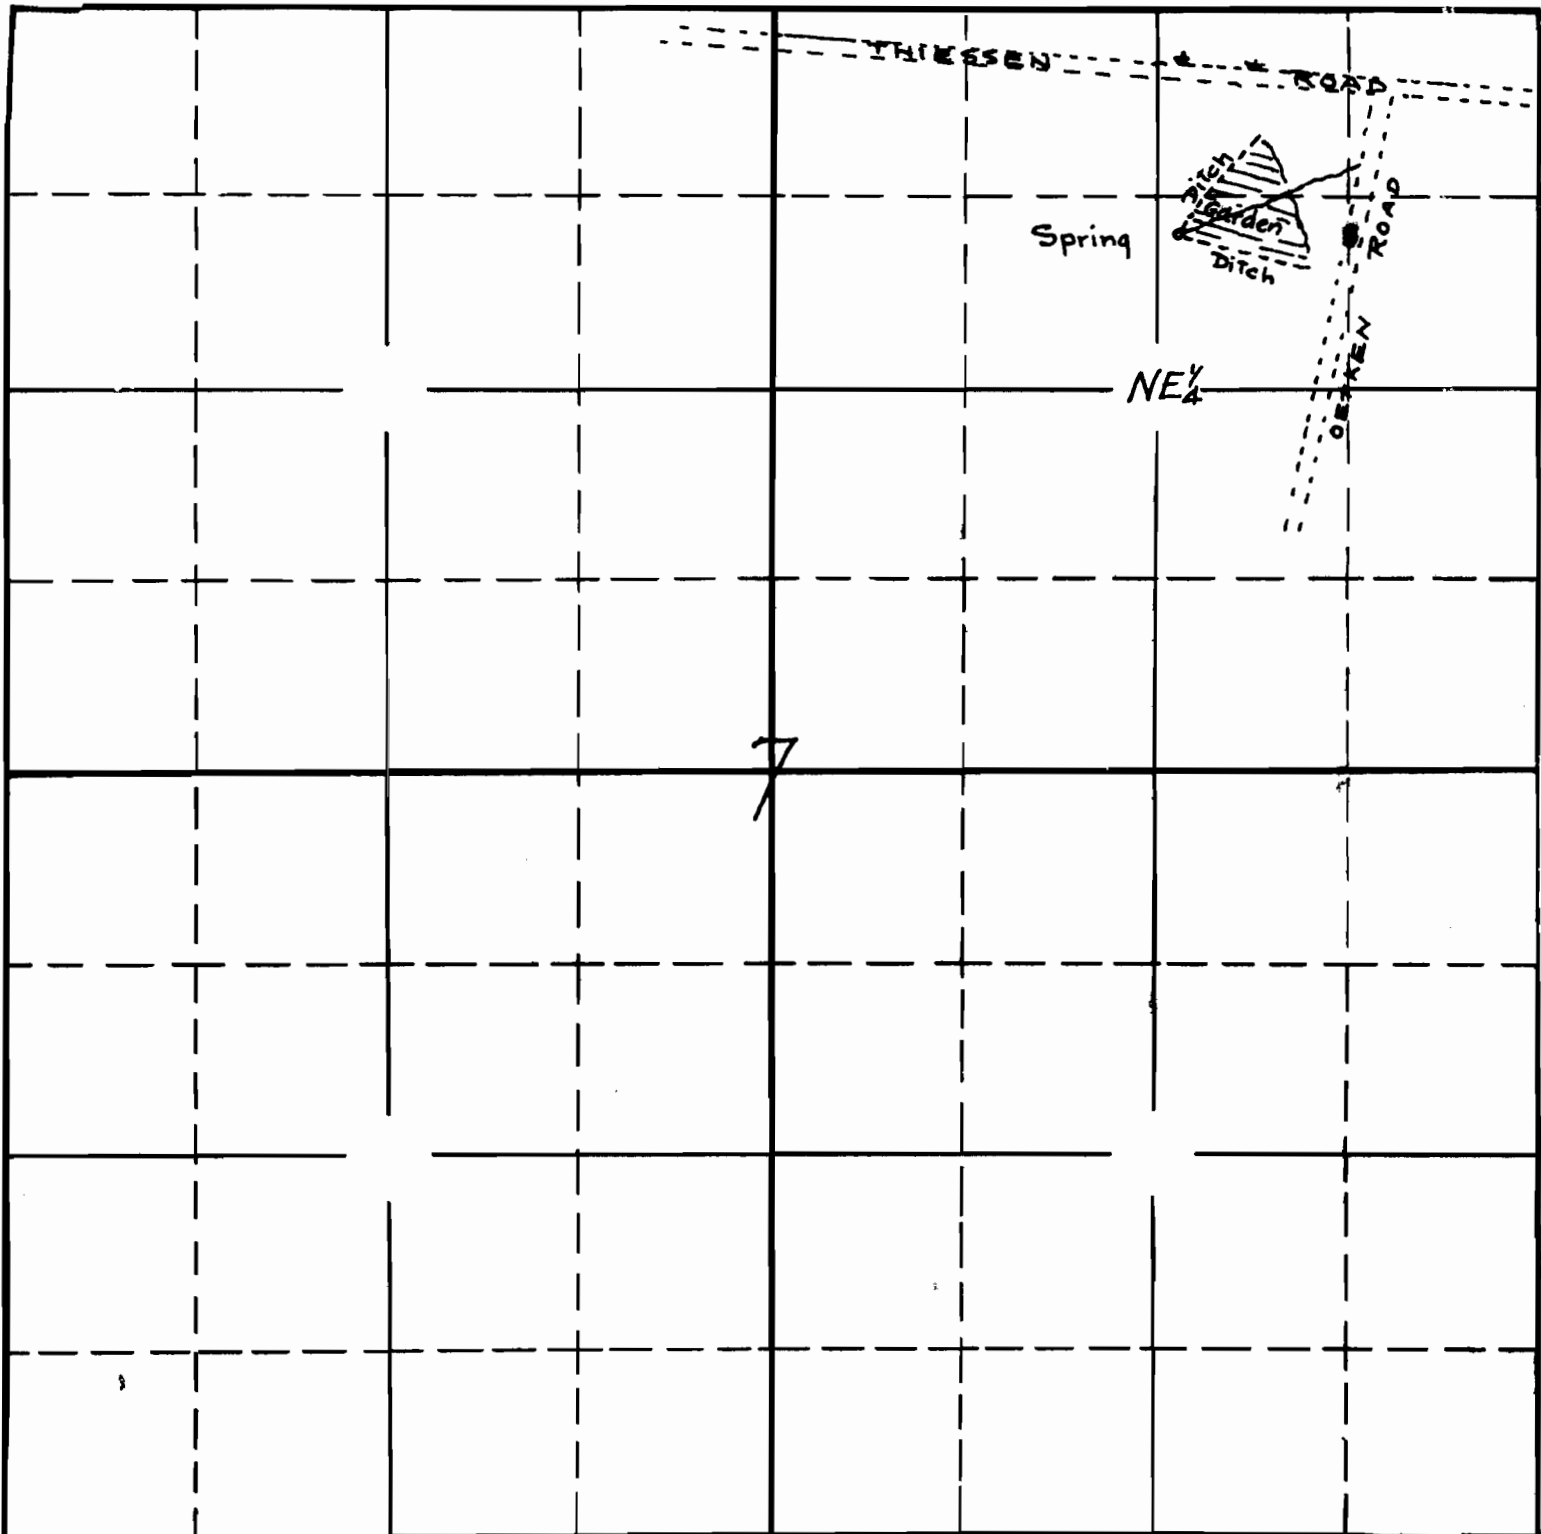

South

APPLICATION No. 13987
PERMIT No. 10074

19279
C 8189
C 9087
15057