


SECTION

TOWNSHIP 21S, RANGE 3W, W. M.

North

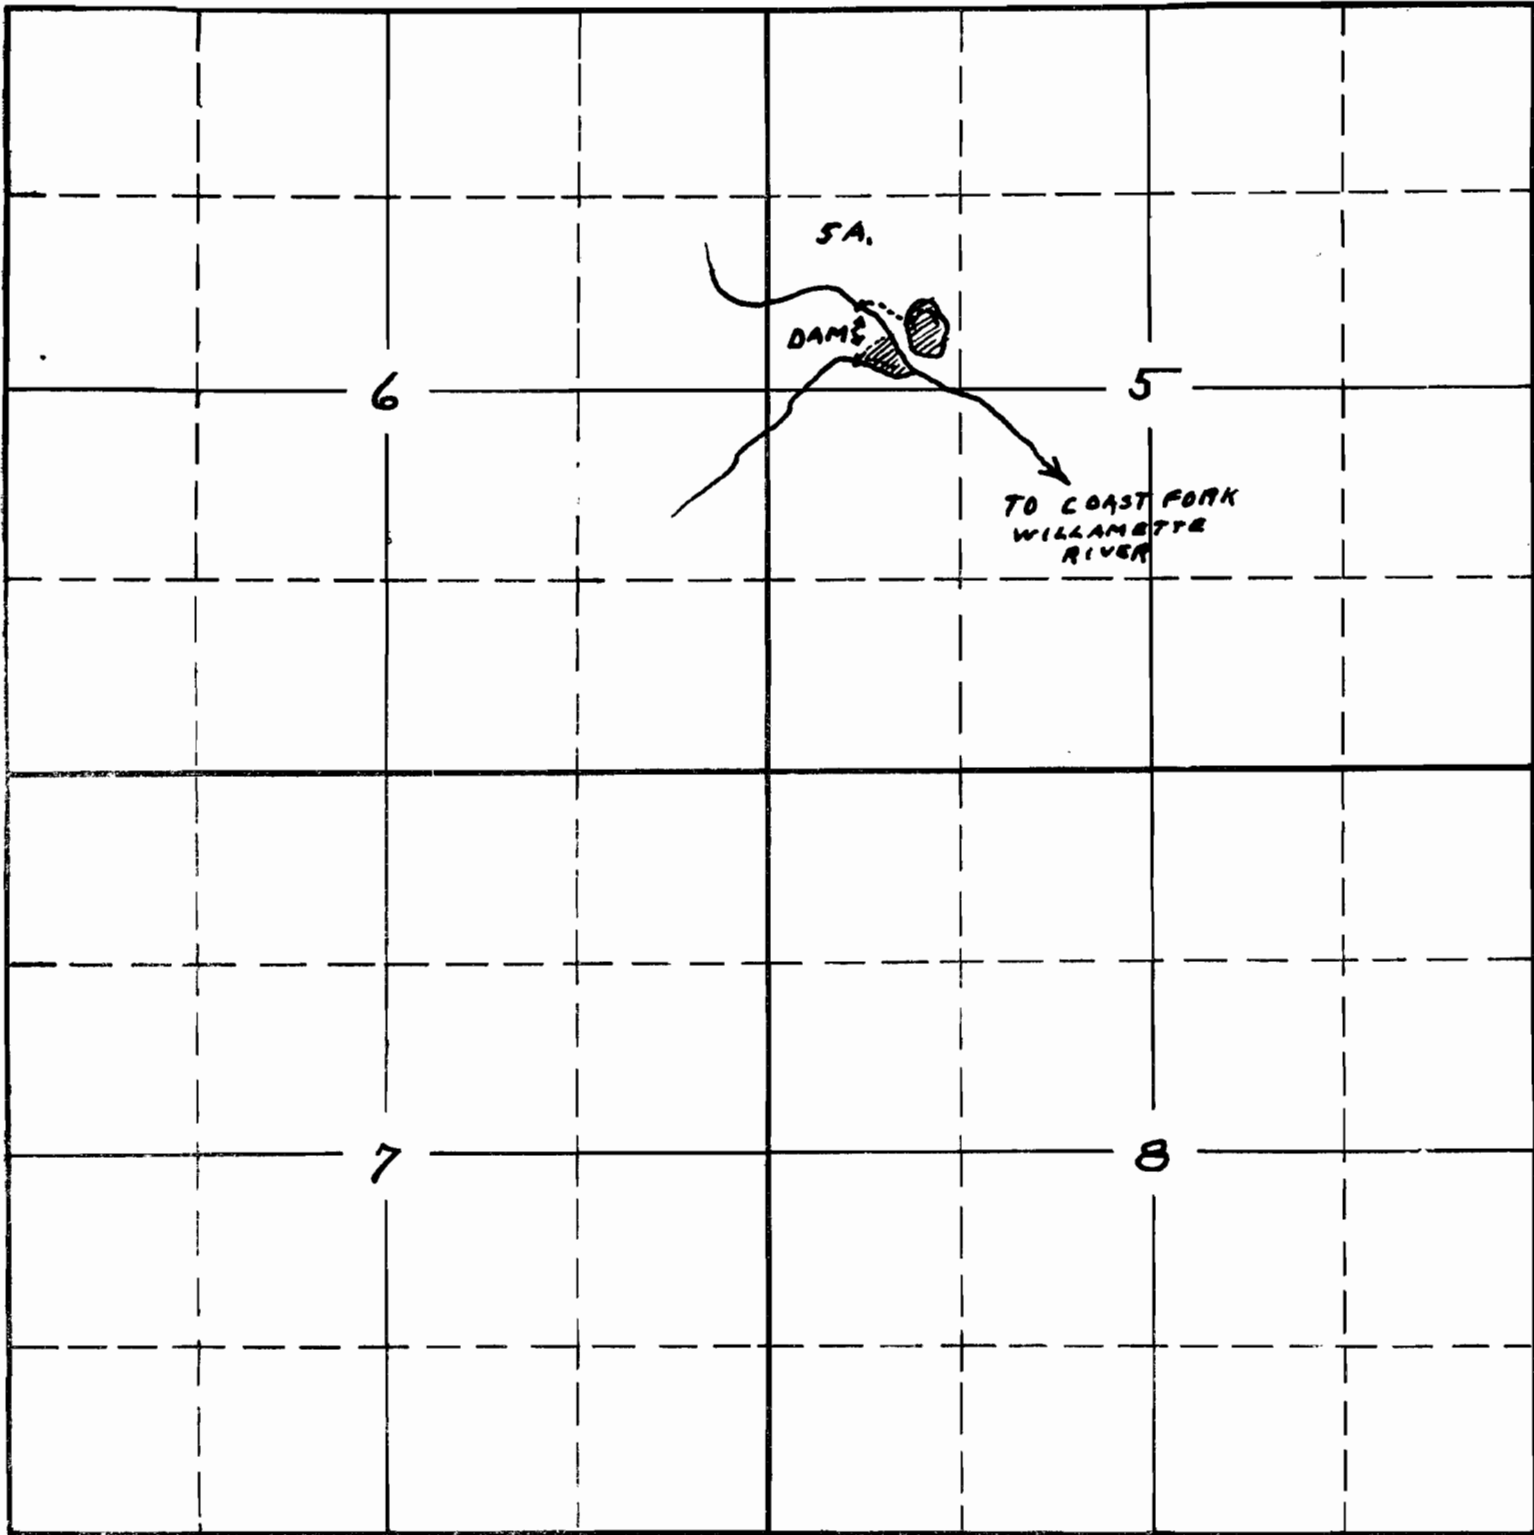

South

APPLICATION No. 14204

PERMIT No. 10320