


Per# 9256
11101

Application No. 12872
Permit No. 9256

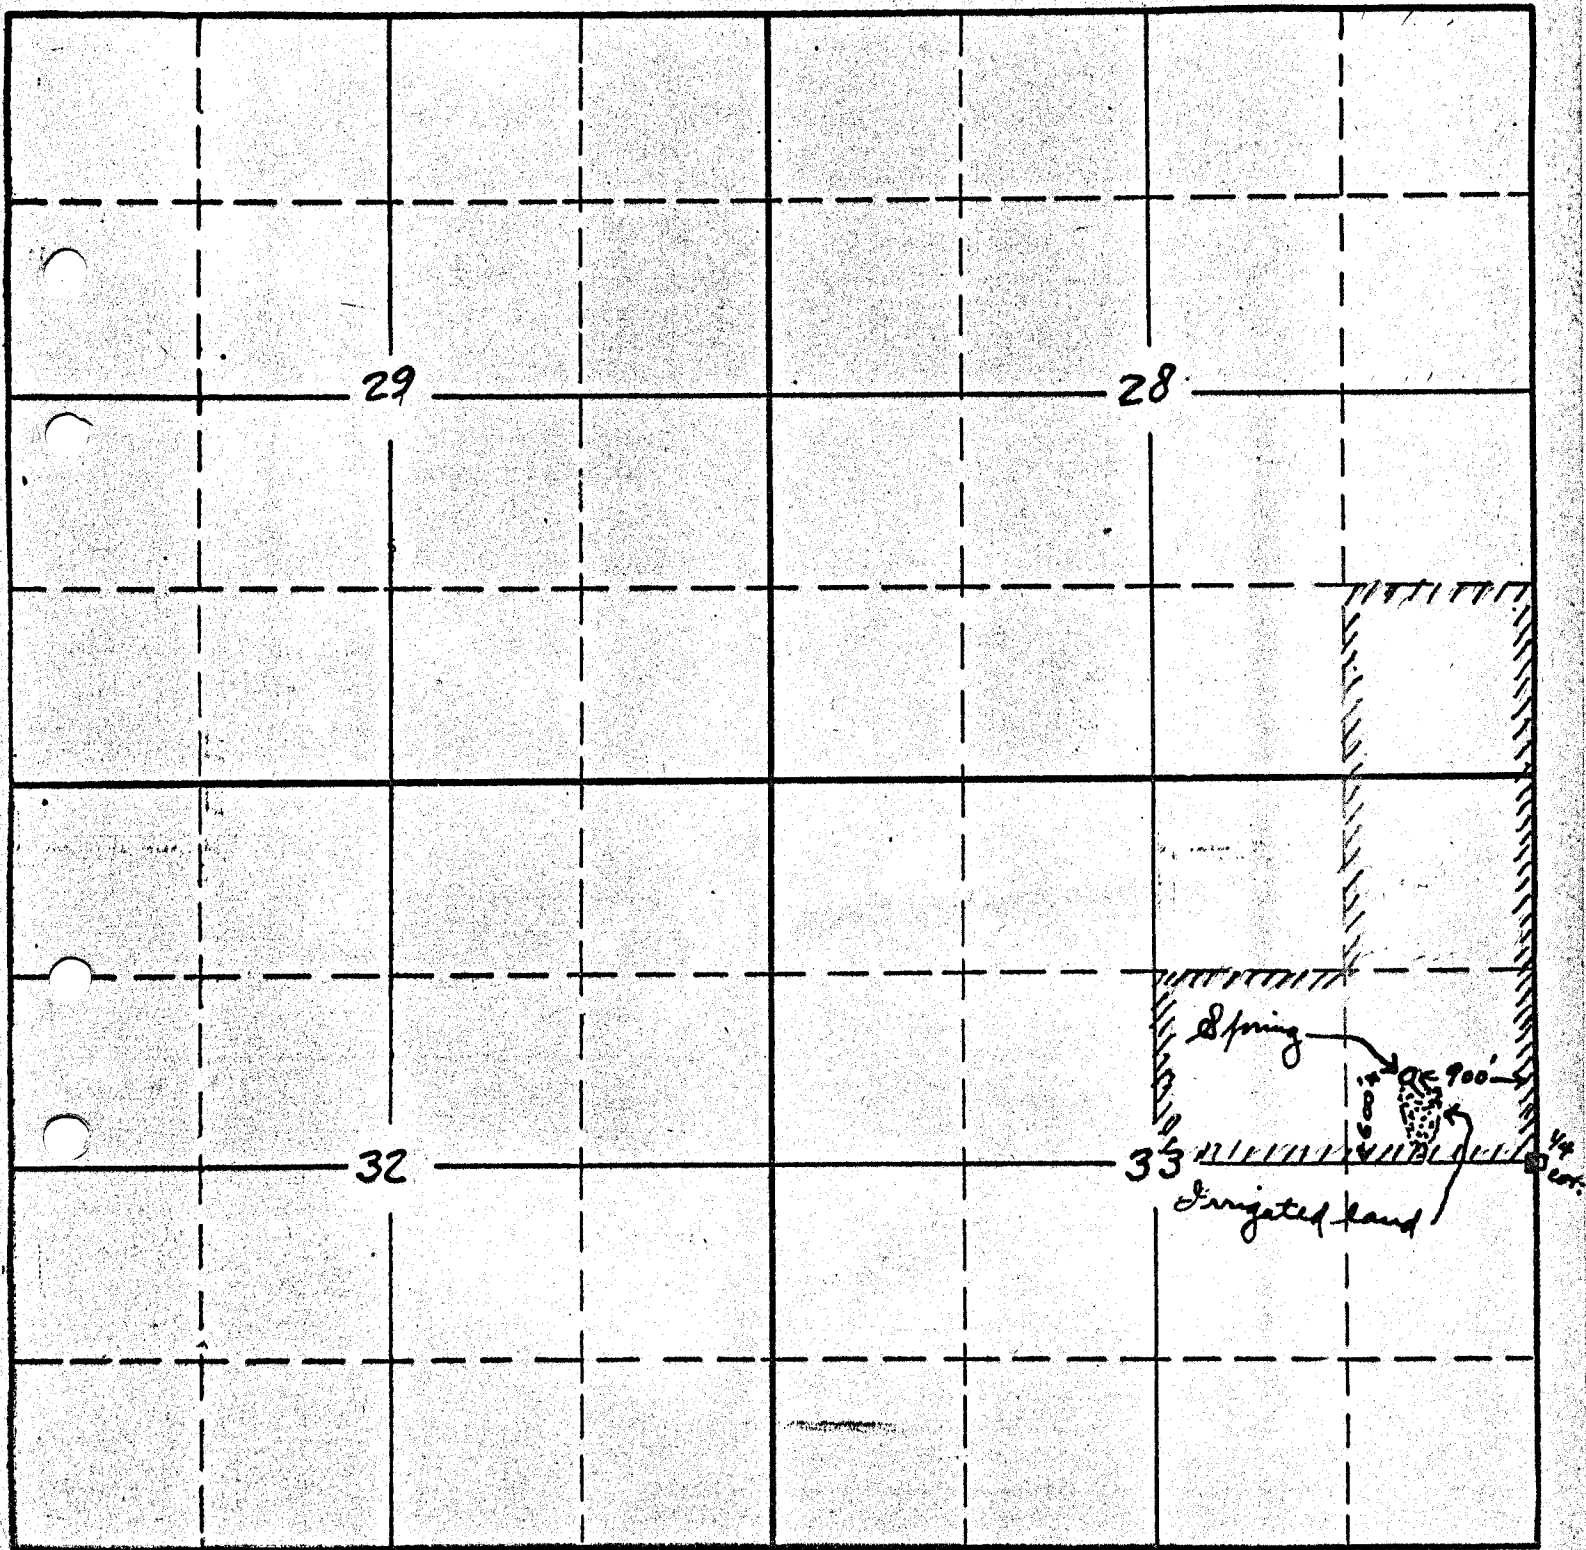

Sec. 28
29
32
33
Tp. 10S
R. 29E W1