
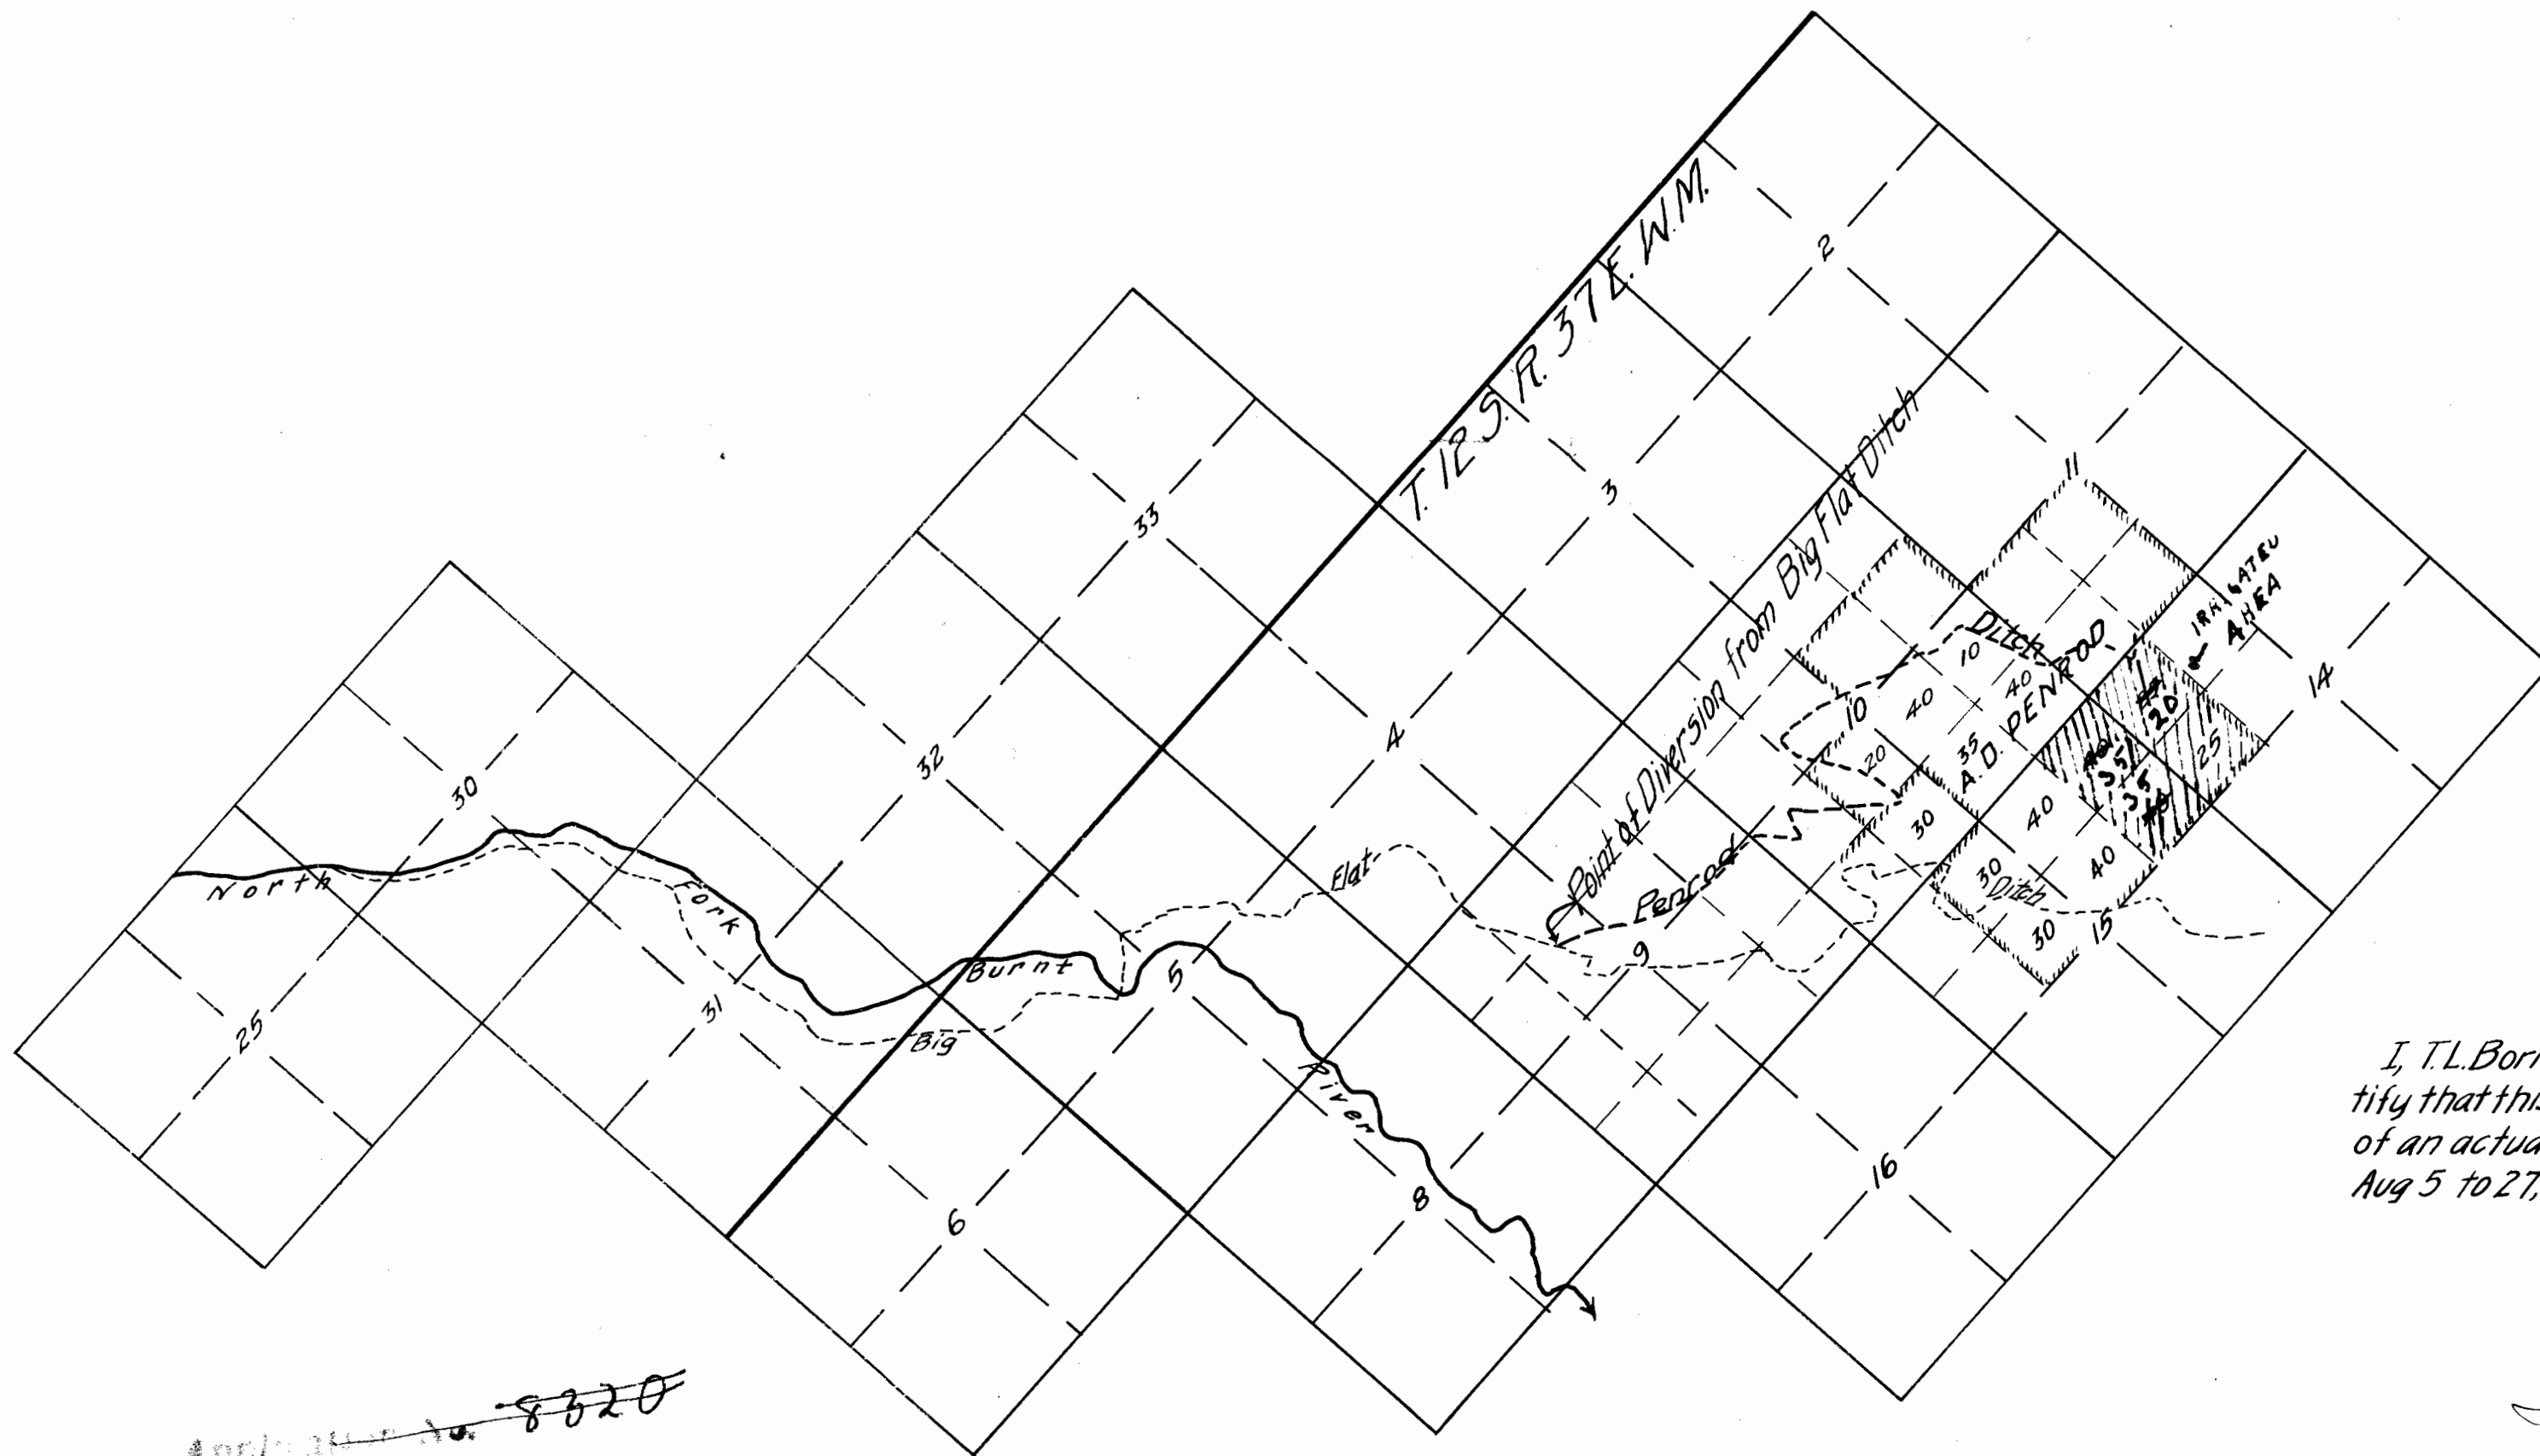


MAP
SHOWING LAND UNDER
PENROD DITCH
Scale 2" = 1 mile

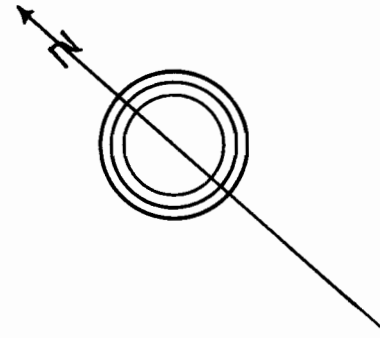

I, T.L. Borman of Baker, Oregon, do hereby certify that this map was made from the field notes of an actual survey under my supervision Aug 5 to 27, 1921

Application No. ~~8320~~
Permit No. ~~5734~~

Application No. 14567
Permit No. 10564

