


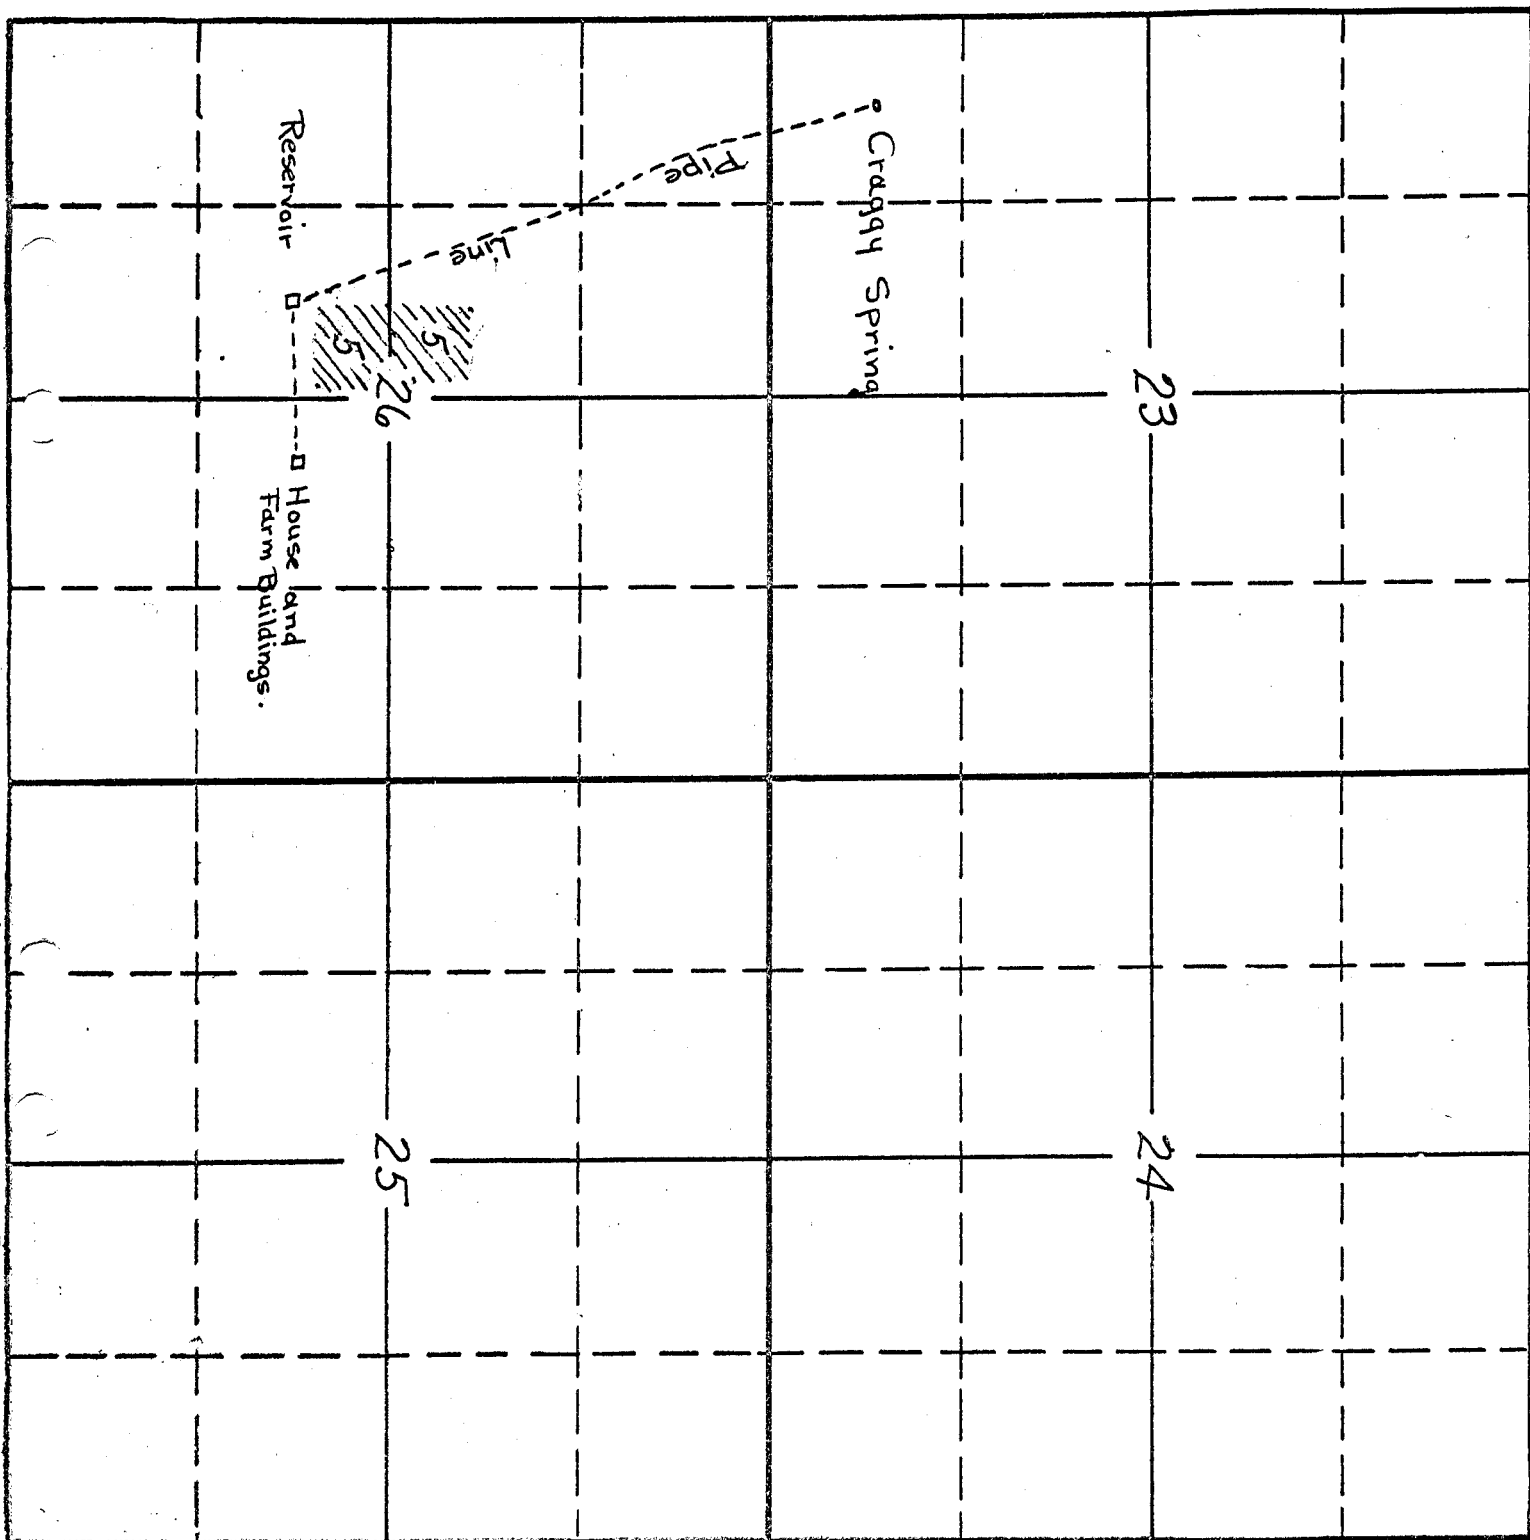

Application No. 12913
Permit No. 9263

Sec. 23
24
25
26
Tp. 8 S
R. 21 E