


SURVEY IN N.W. 1/4, N.W. 1/4, SECT. 7, TWP. 2 N., RANGE 8, EAST W. M.

FOR ADA FULGHAM.

DATE 3/17/30.

N.W. COR. SEC. 7.

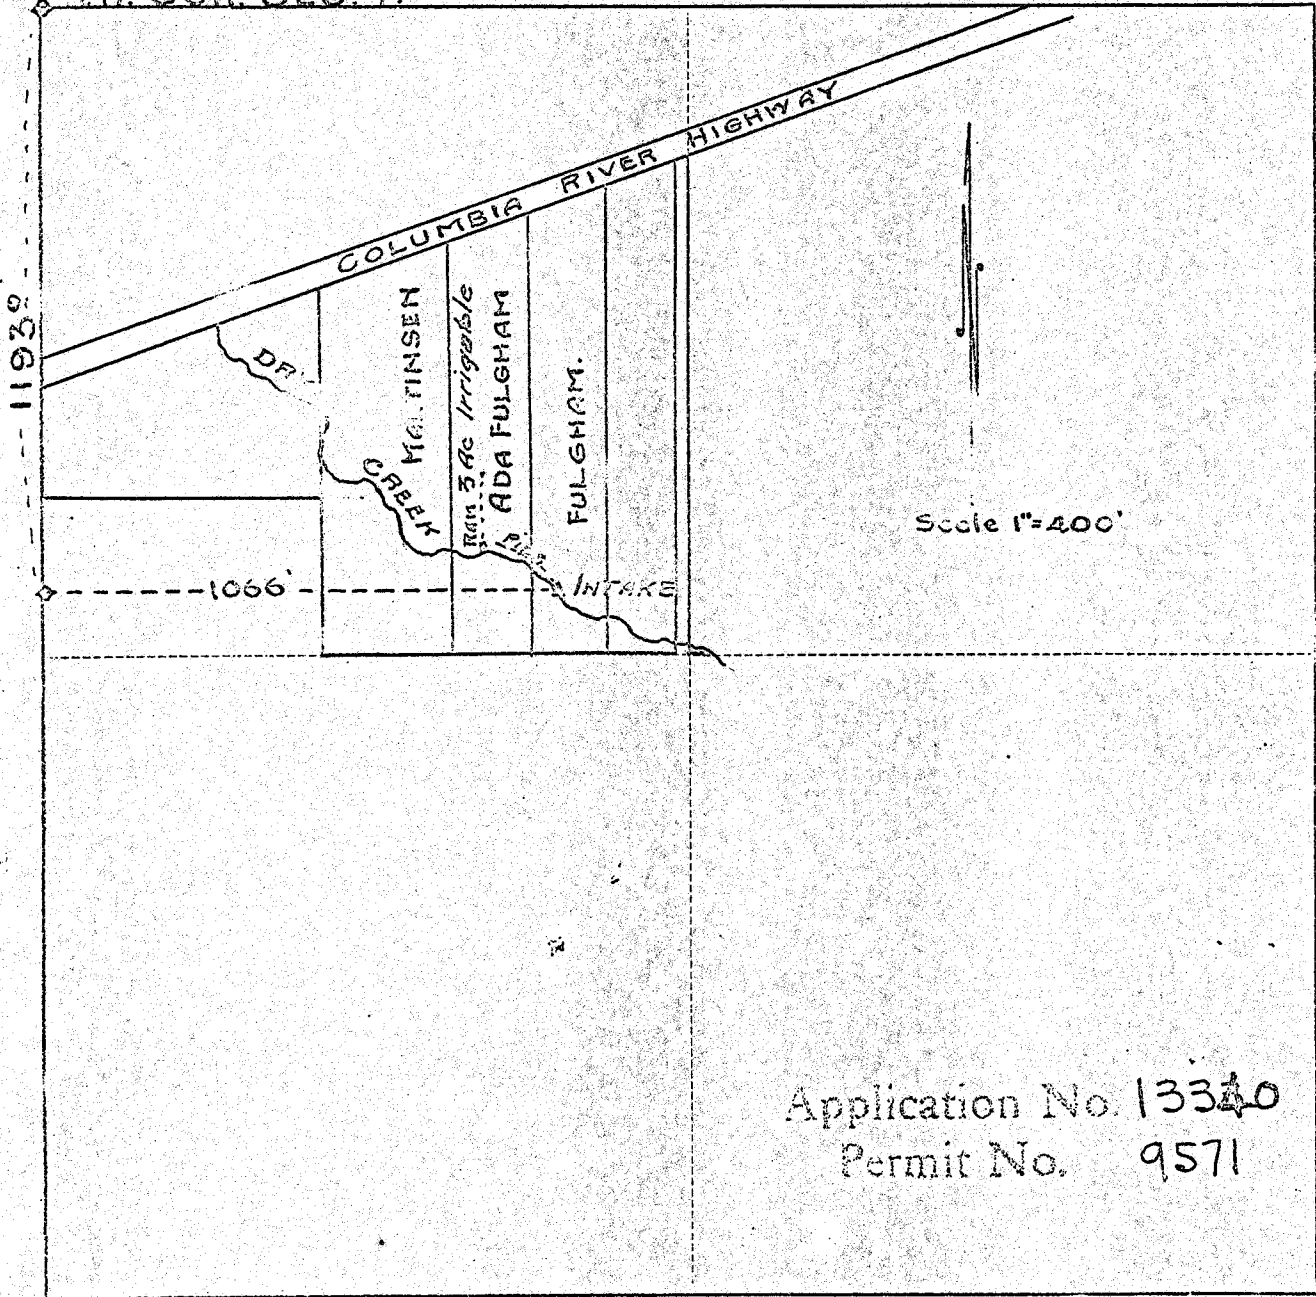

Application No. 13340
Permit No. 9571

I do hereby certify that this sketch was made from notes taken during an actual survey made by me on March 17, 1930, and that it correctly represents field work of said survey.

C. M. Newcomb
County Surveyor
Hood River County, Oregon

Helpers J. H. MARTINSEN