


MAP SHOWING WATERFILING OF J.C. SOUTH
GRANDVIEW OREGON
scale 1" = 400'

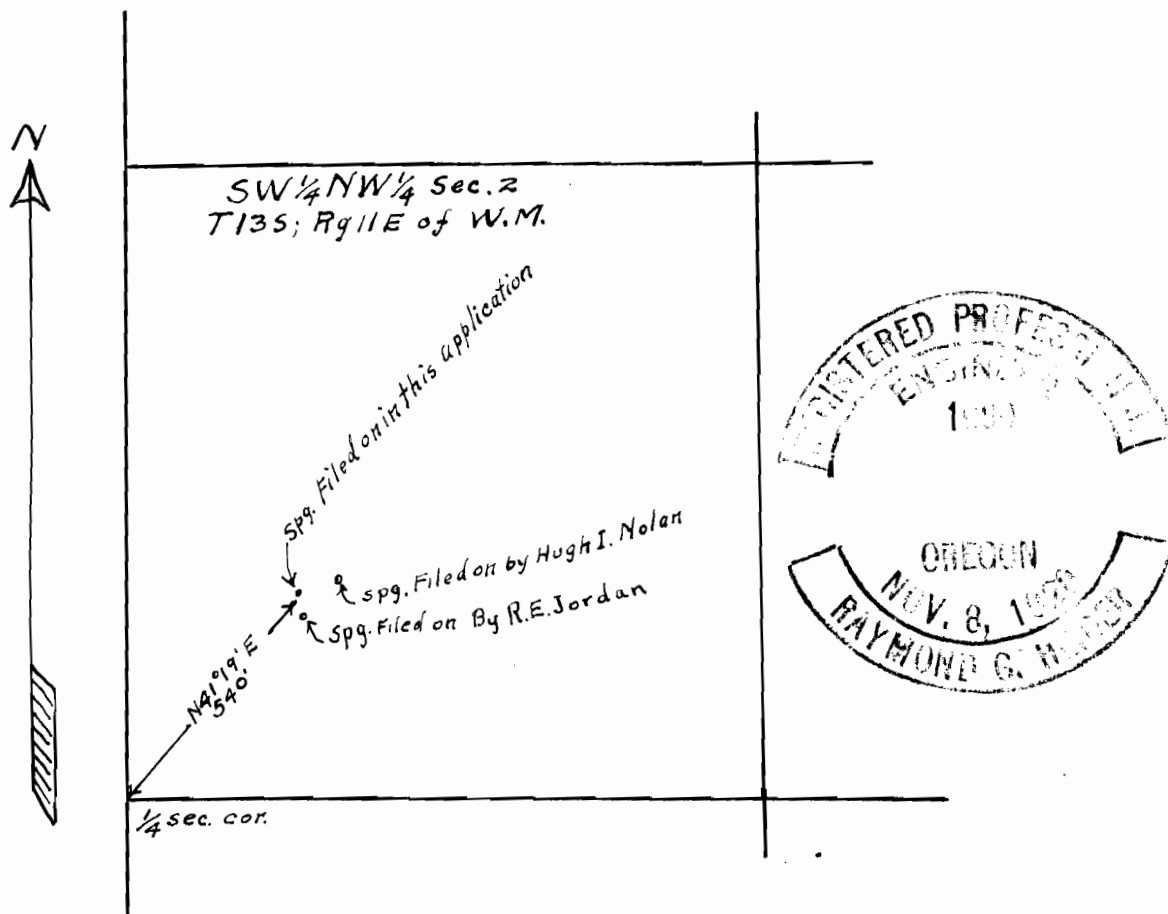

I, Raymond G. Heider of Klamath Falls Oregon, do hereby certify that this map was made from notes taken during an actual survey made under my direction on Jan. 25 1931 and that it correctly represents the works described in the accompanying application together with the location of streams and other ditches in the immediate vicinity.

Raymond G. Heider
Engineer

13459

10057