


SECTION

TOWNSHIP 26 S, RANGE 3 W, W. M.

North

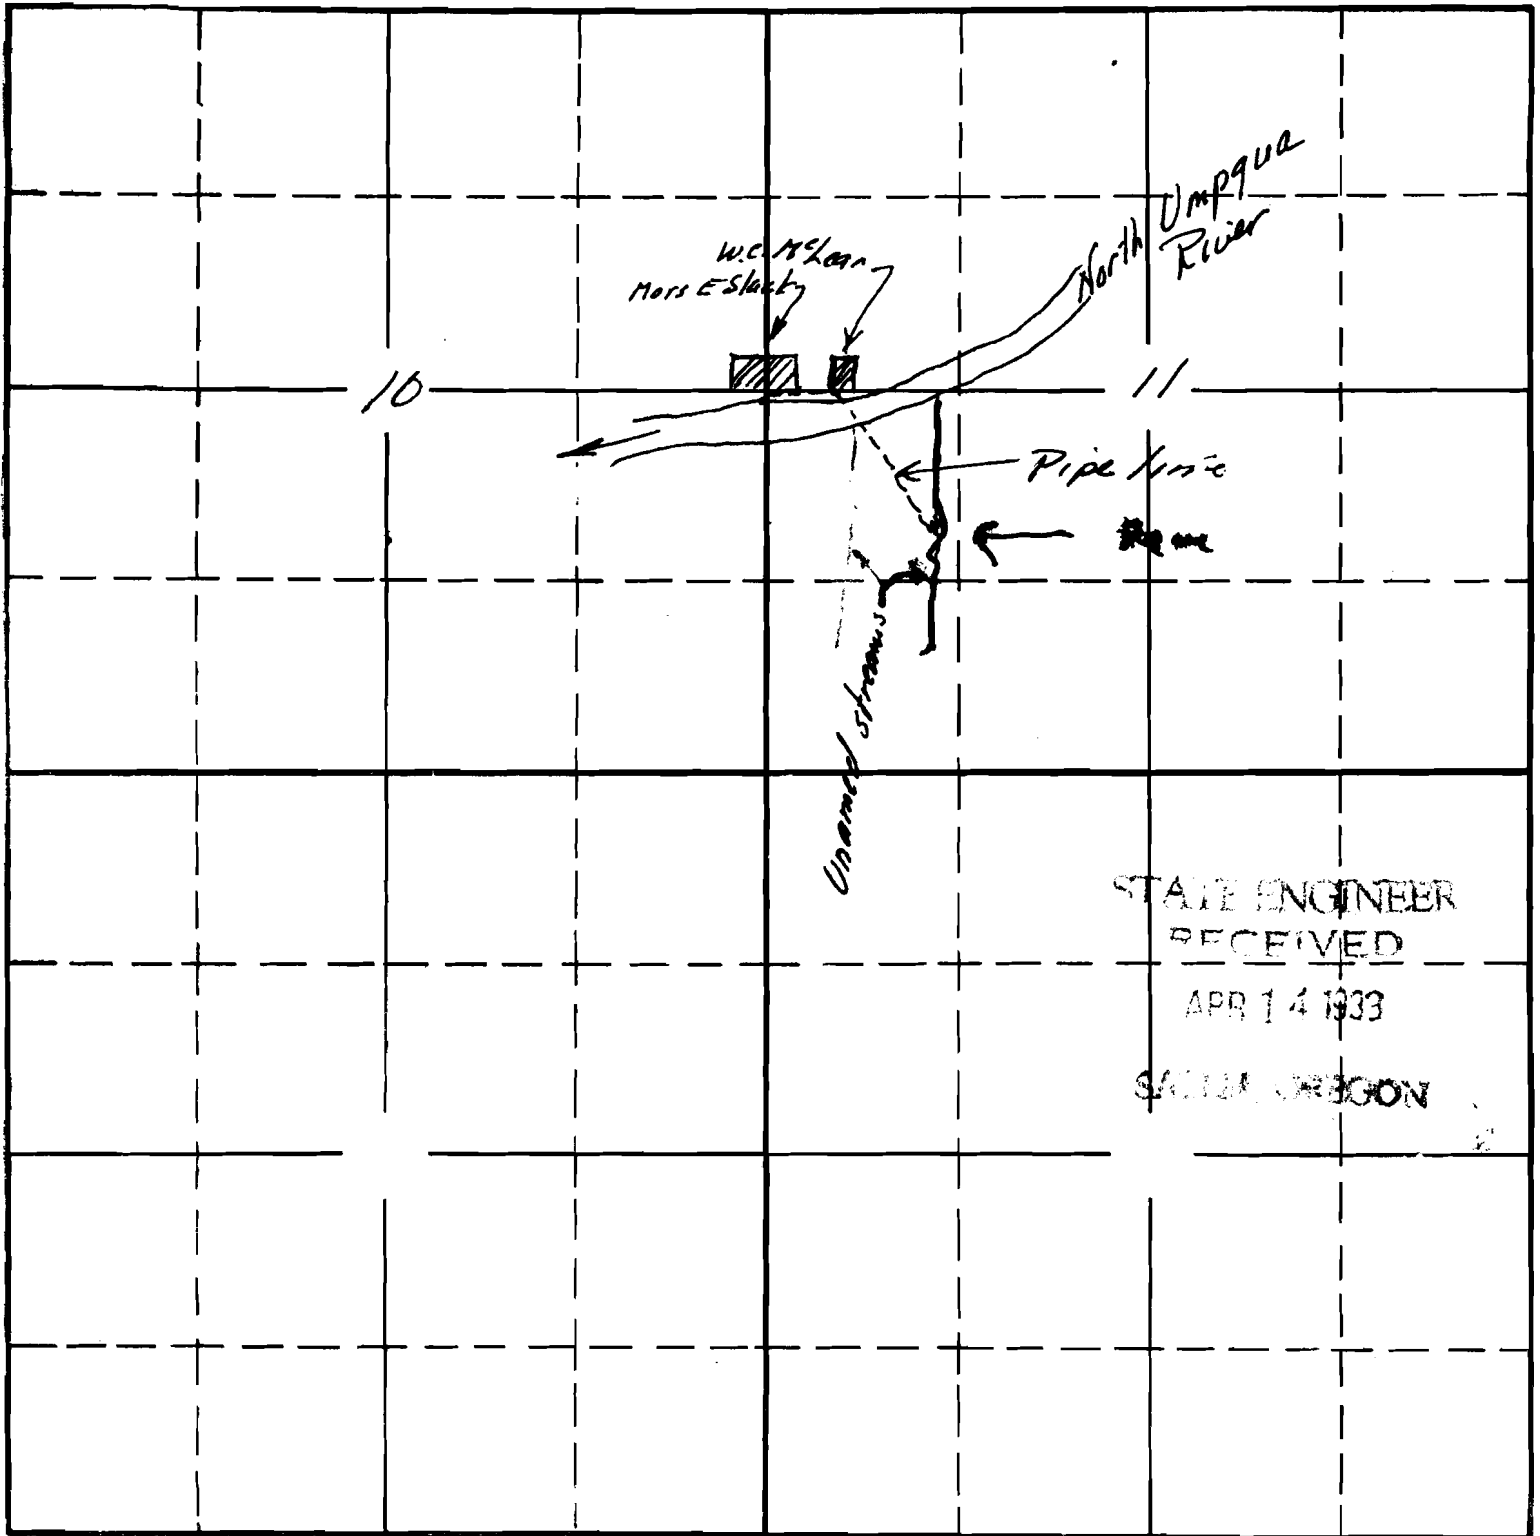

South

APPLICATION No. 14901
PERMIT No. 10861