


Application *

STATE OF OREGON

DEPARTMENT OF AGRICULTURE

PERMIT NO. 2718

2718

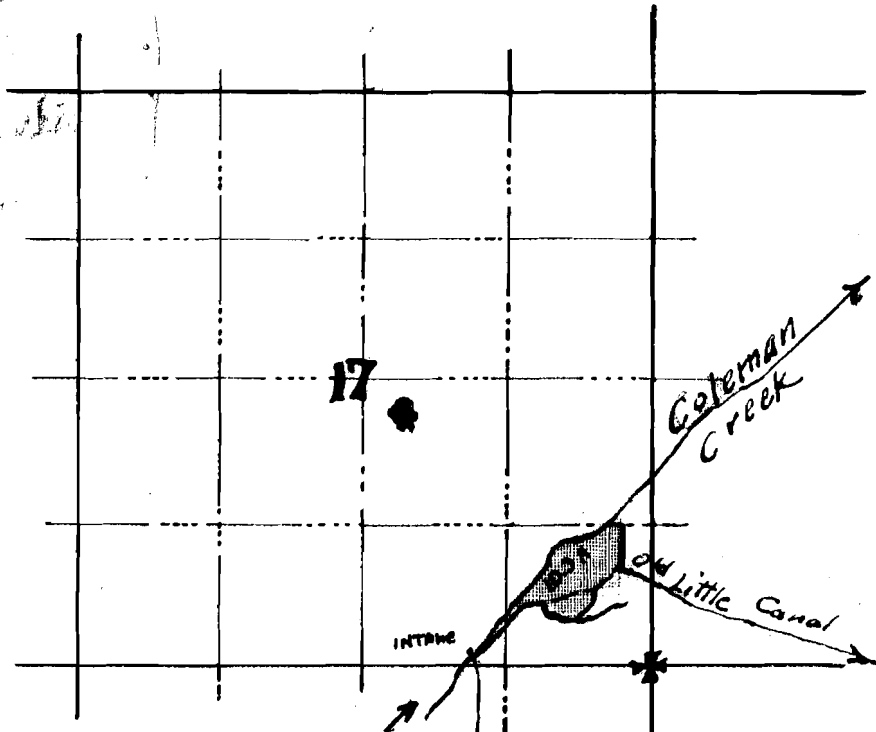

Application No. 2718
Permit No.

{ N-94'
W-1592' from Corner
16-47-20-20
T. 30 S. R. 1 W. W.M.

I. L. W. Whiting, of Medford Oregon, do hereby certify that this map was made from notes taken during an actual survey made by me on Dec. 23, 1912. and that it correctly represents the works described in the accompanying Application together with the location of Streams and other ditch in the immediate vicinity. and has written thereon the area proposed to Irrigate.

L. W. Whiting
Civil Engineer.