


SECTION

TOWNSHIP 40S, RANGE 4W, W. M.

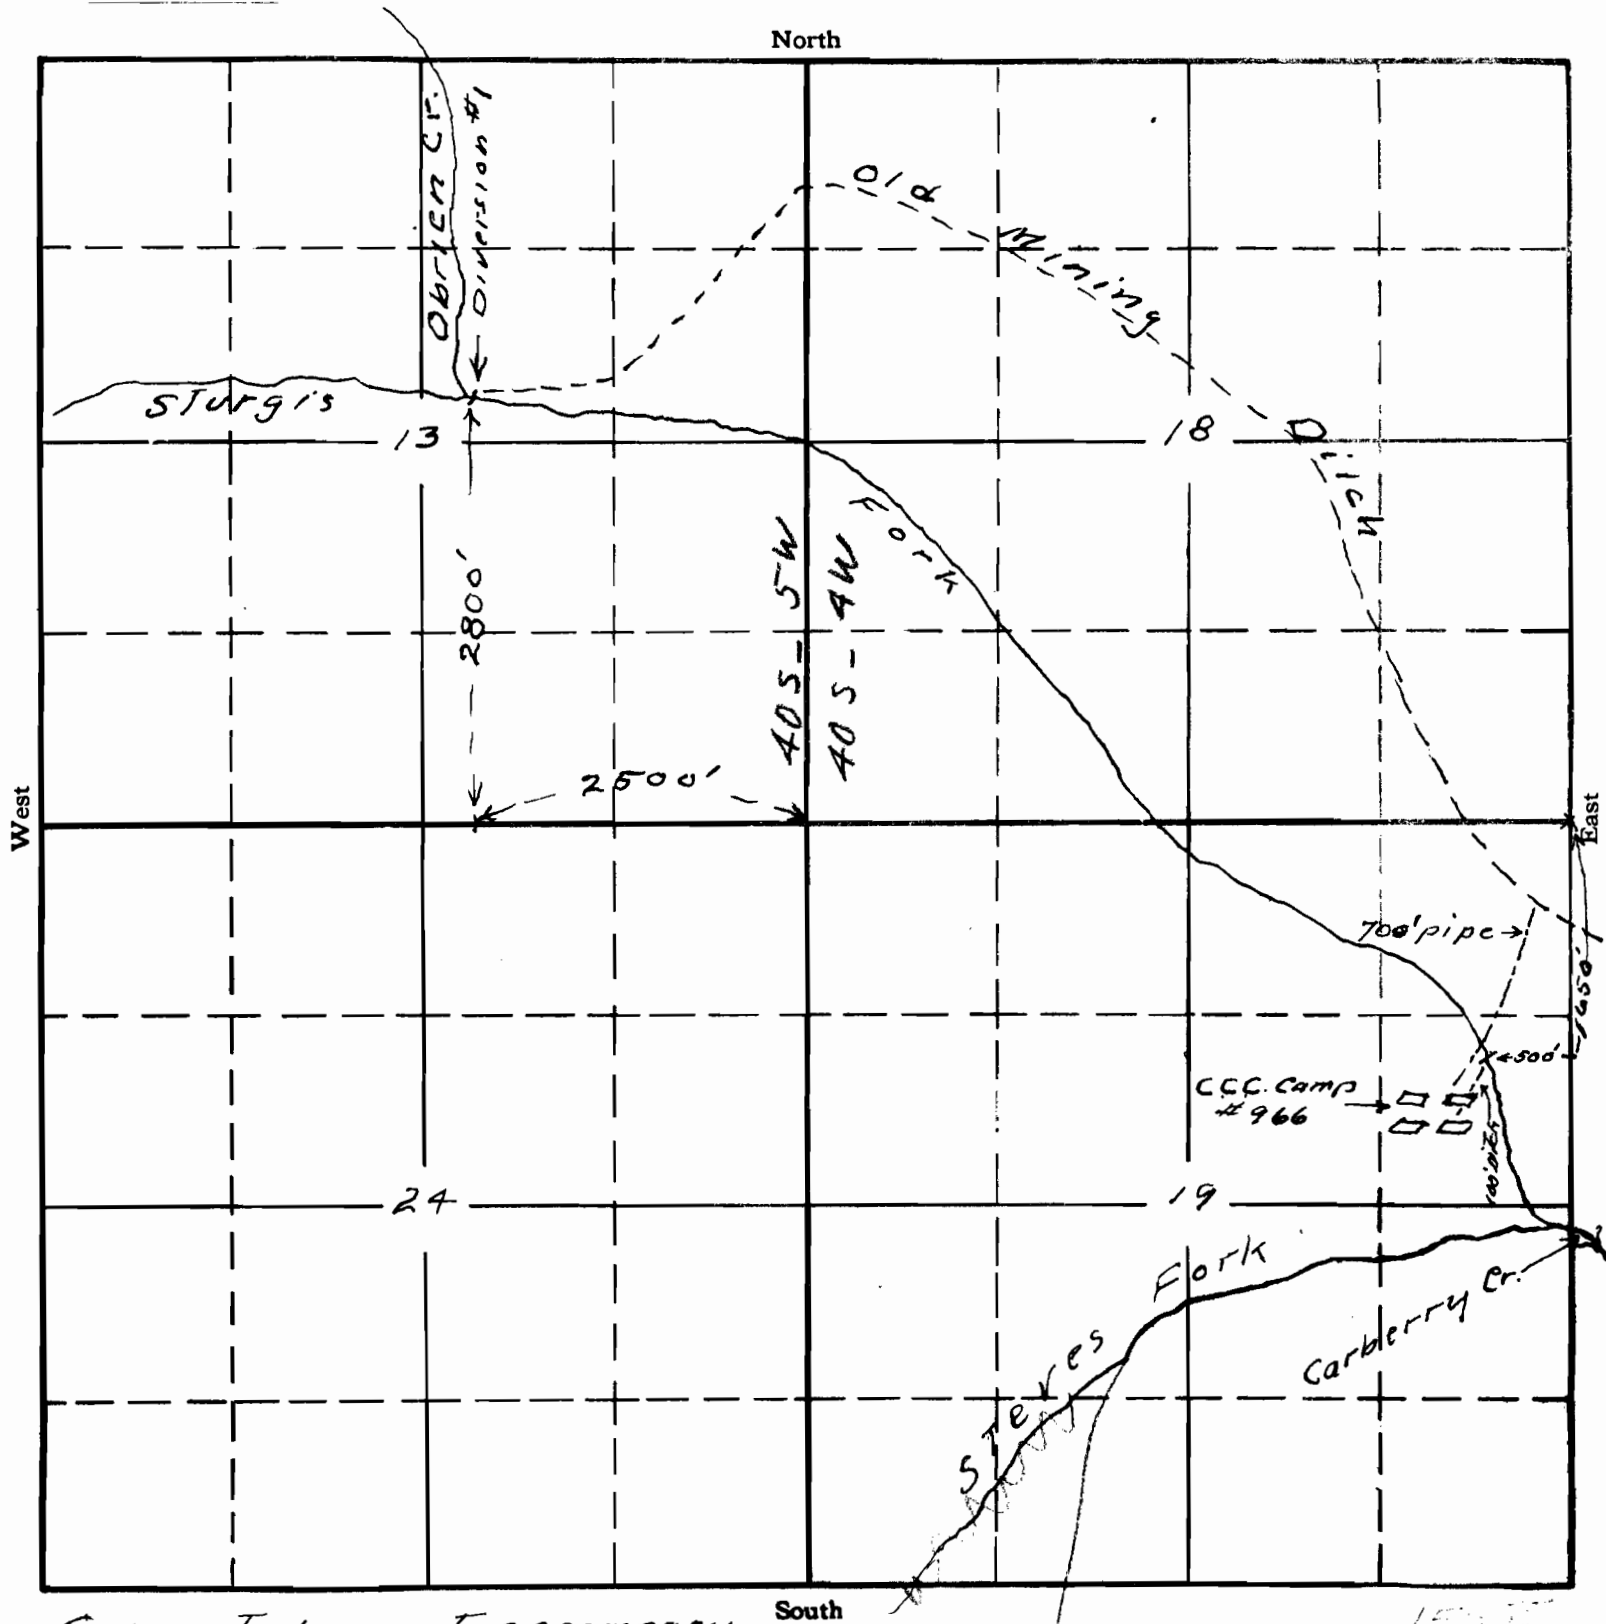

Corrected map to accompany
application of Civilian Conservation Corps
Camp #966
Made from sketch drawn by government
location survey.
App. Taken out by Capt C L Pierce Commanding 2nd Reserves.

APPLICATION No. 15655
PERMIT No. 11523