



# Range 22 E.W.M.

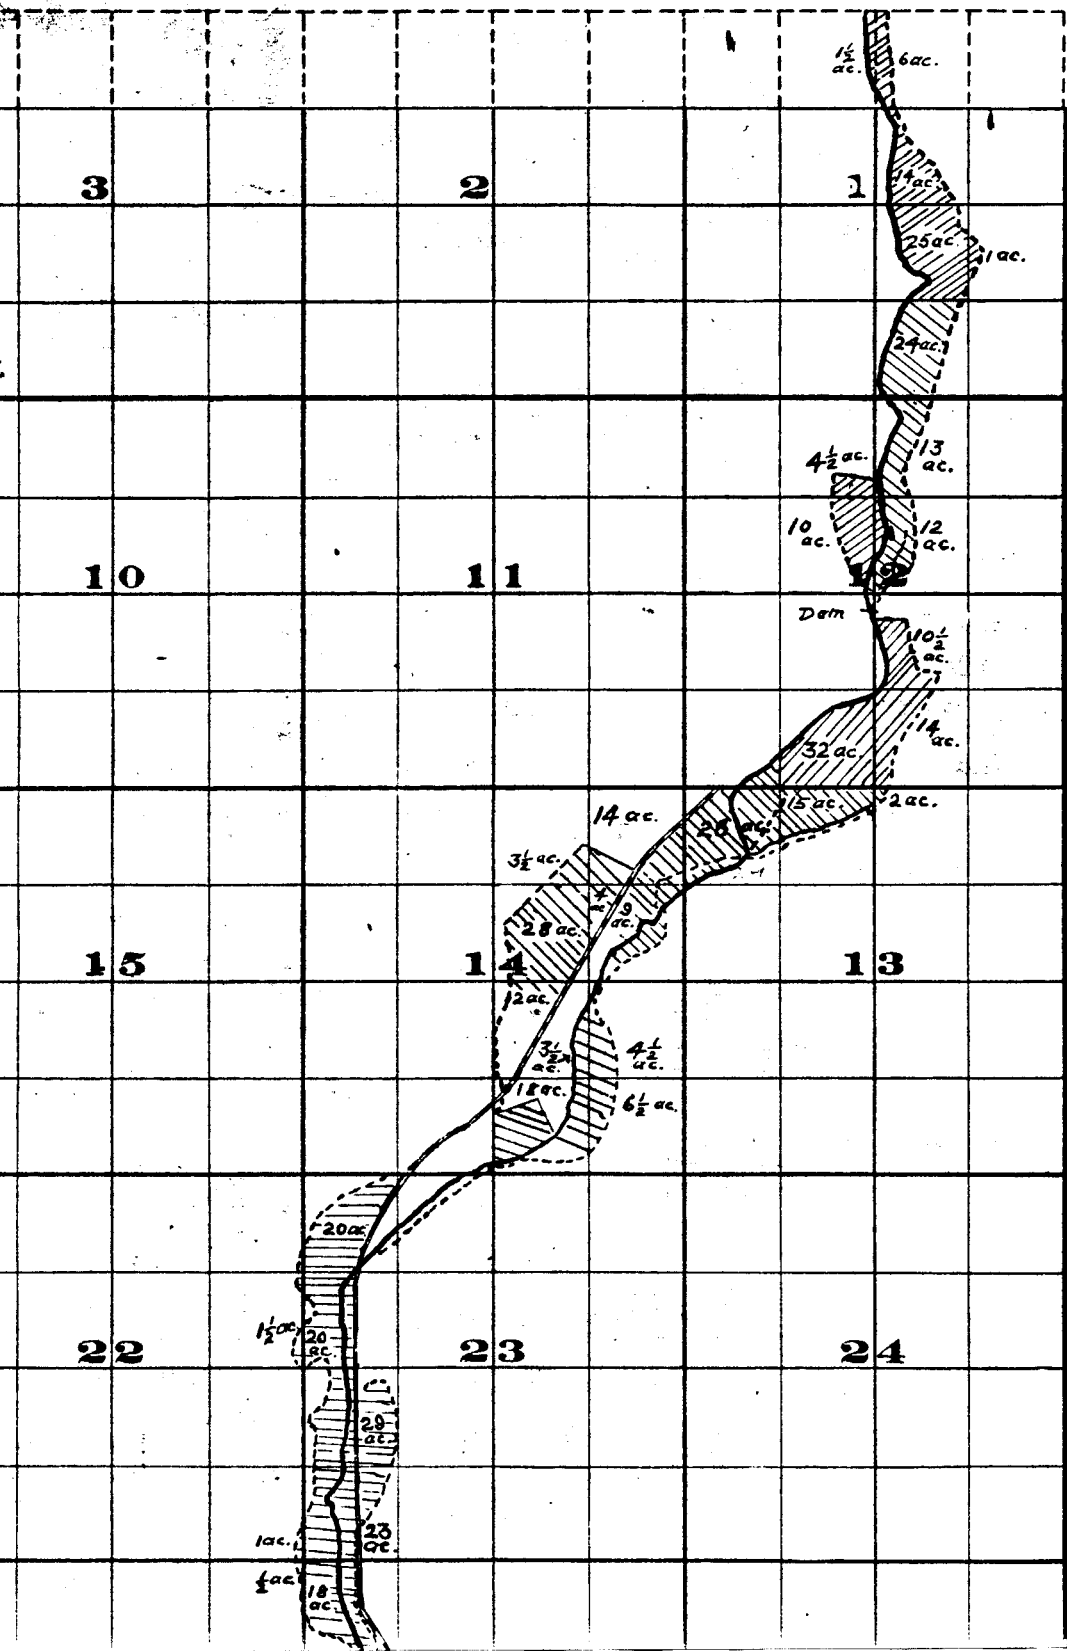

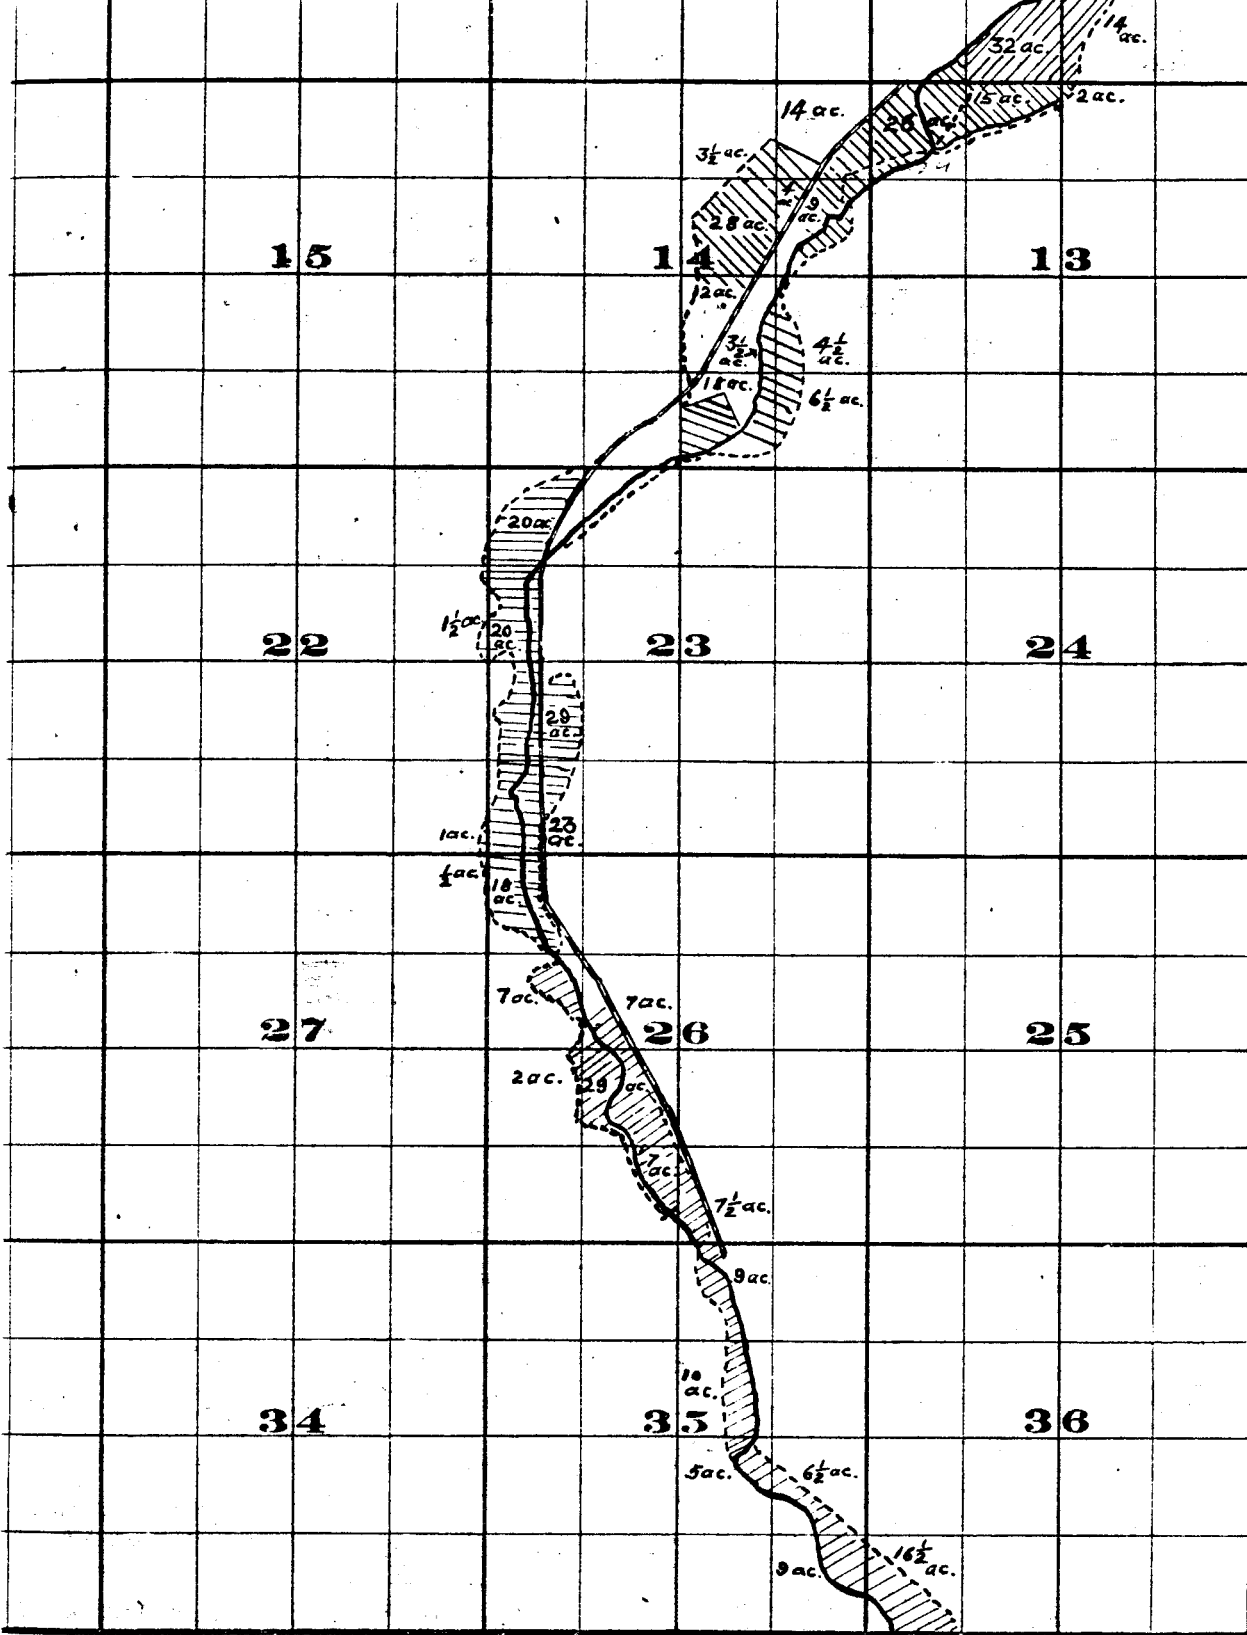





FROM OFFICE OF THE STATE ENGINEER, SALEM, OREGON

*Willow Creek Adjudication.*

3 N. 22