


11335

SECTION

24
2N10E
2N11E

TOWNSHIP _____, RANGE _____, W. M.

2710 E. W.M North 2711

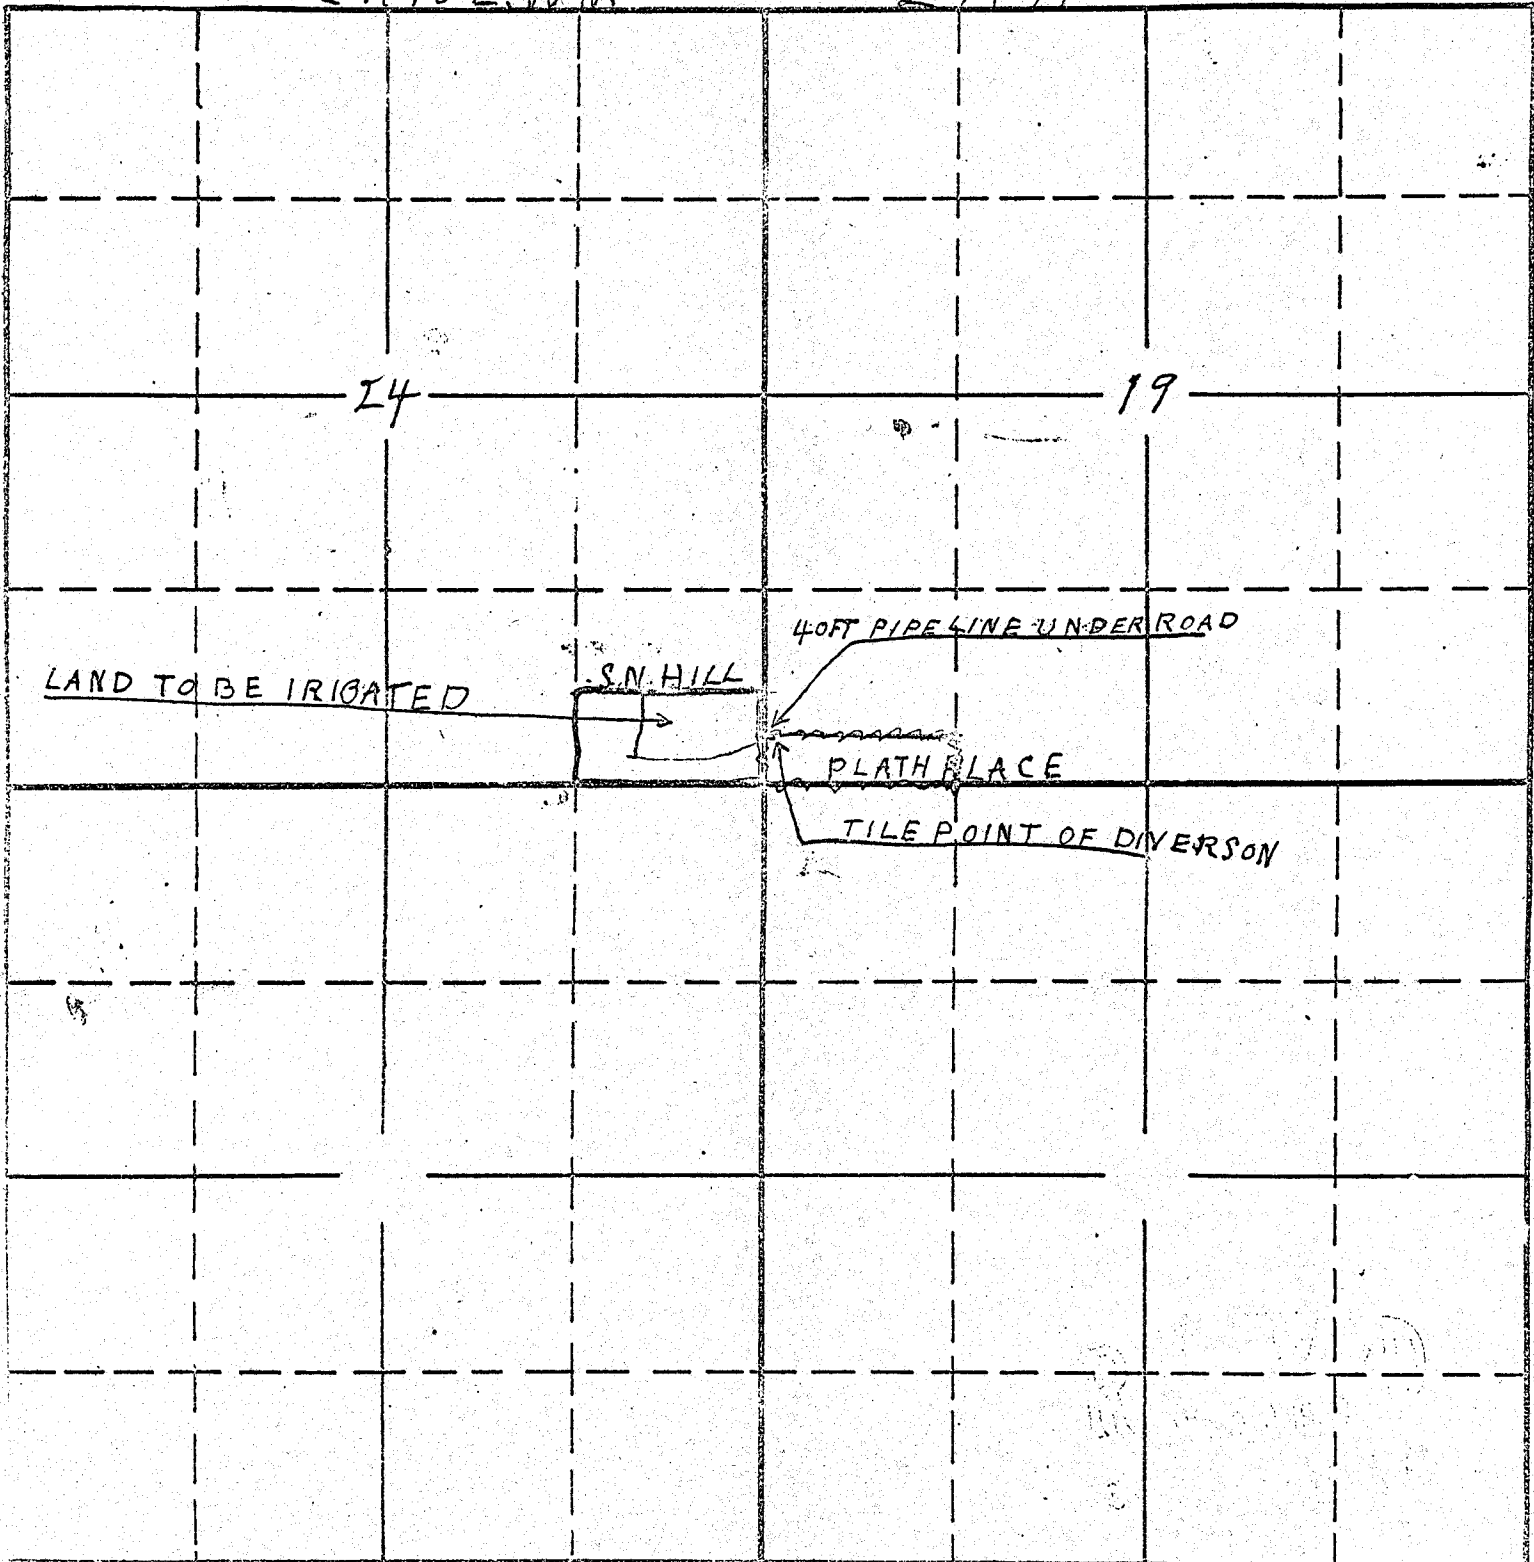

South

APPLICATION No. 15328

PERMIT No. 3

11325