


SECTION

TOWNSHIP 35, RANGE 1W, W. M.

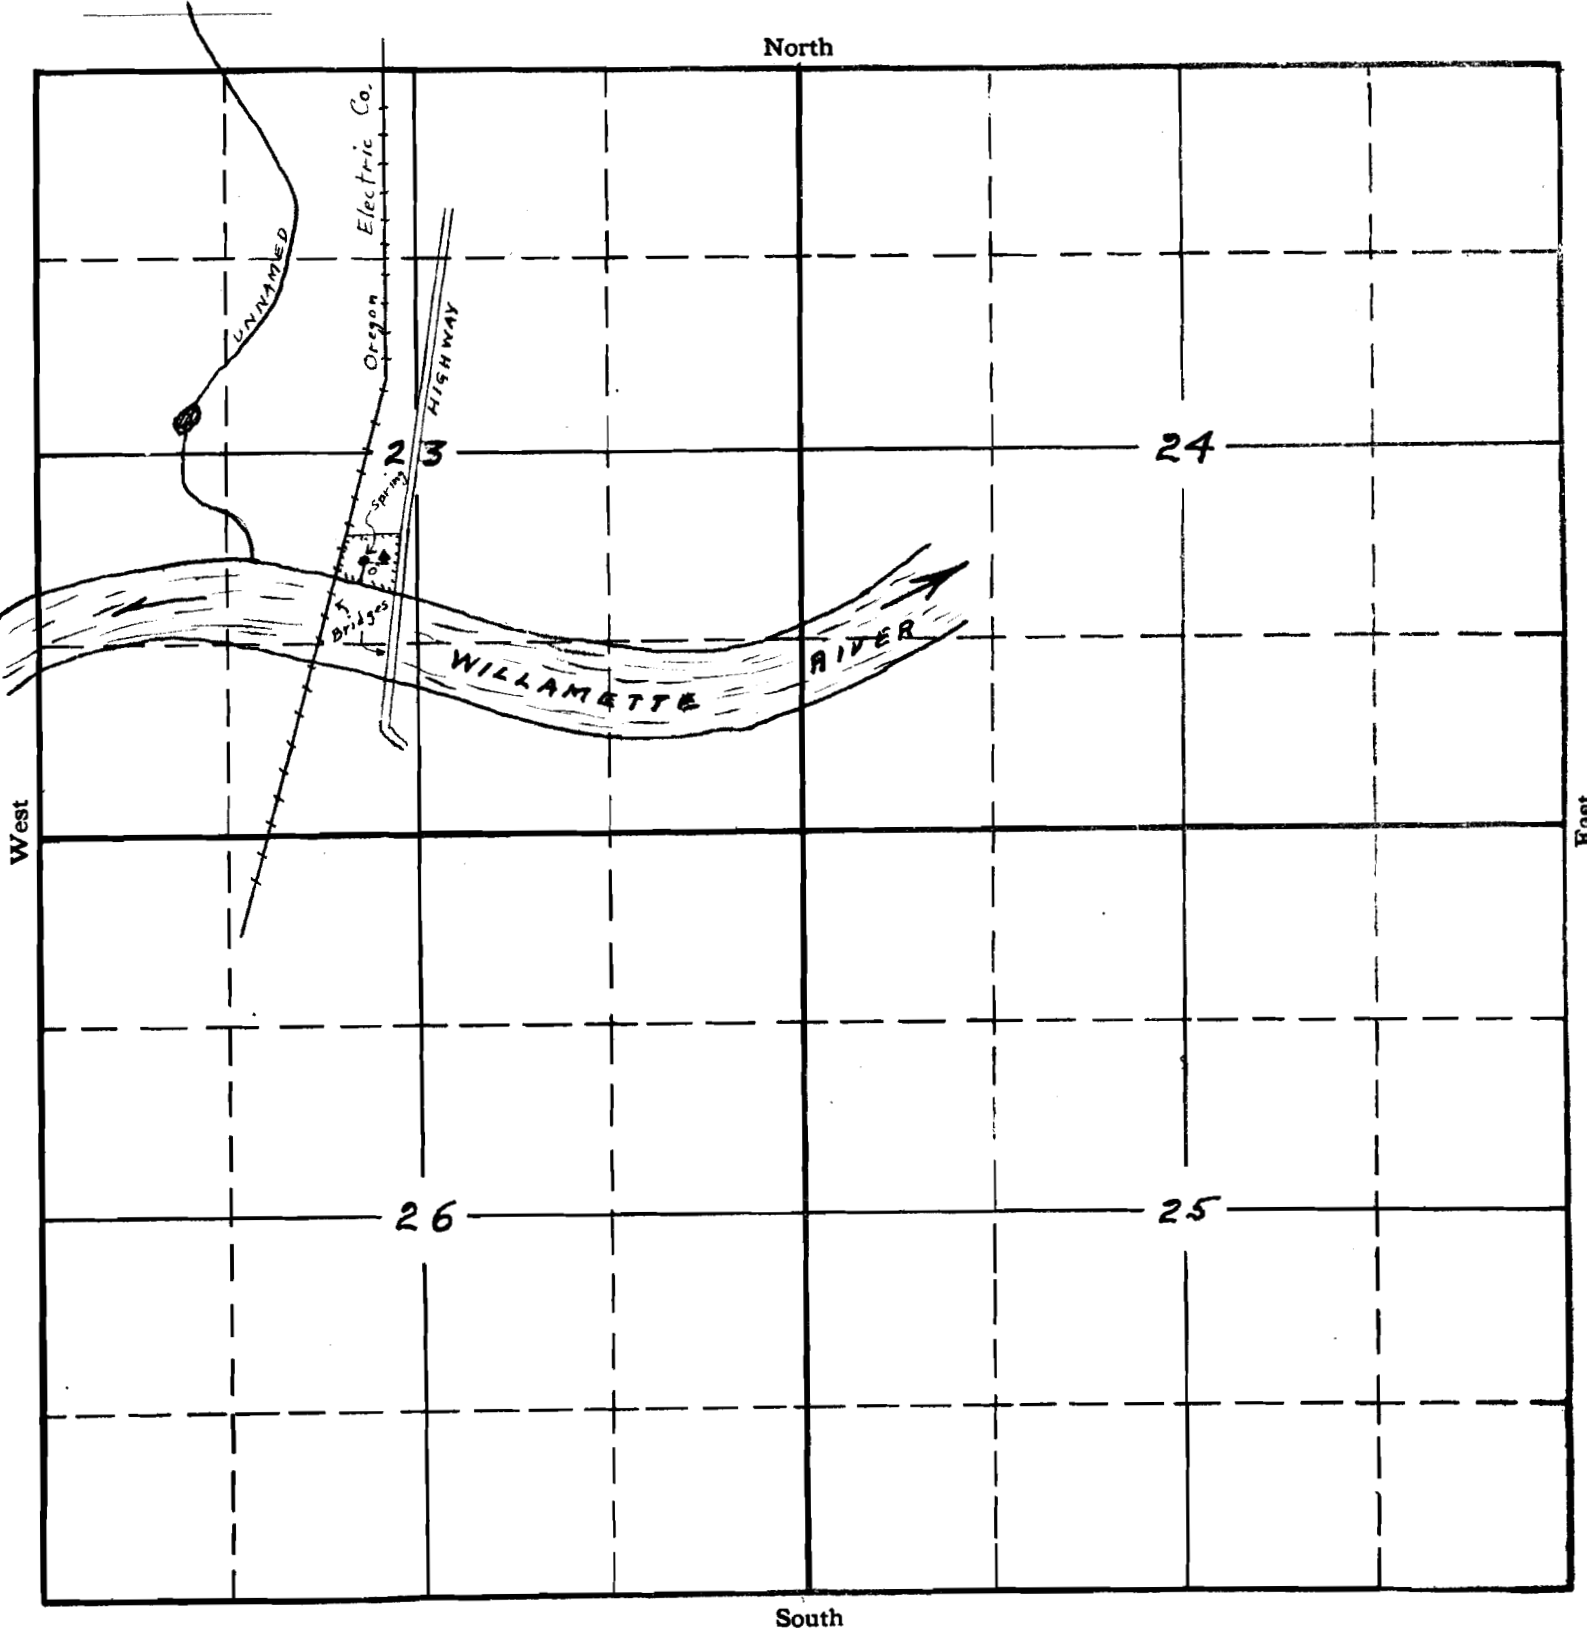

APPLICATION No. 15677
PERMIT No. 11554