


BLACK BEAR ^{Per 11453}

Placer Mine

E $\frac{1}{2}$ SW SE Sec 2 Tp 12

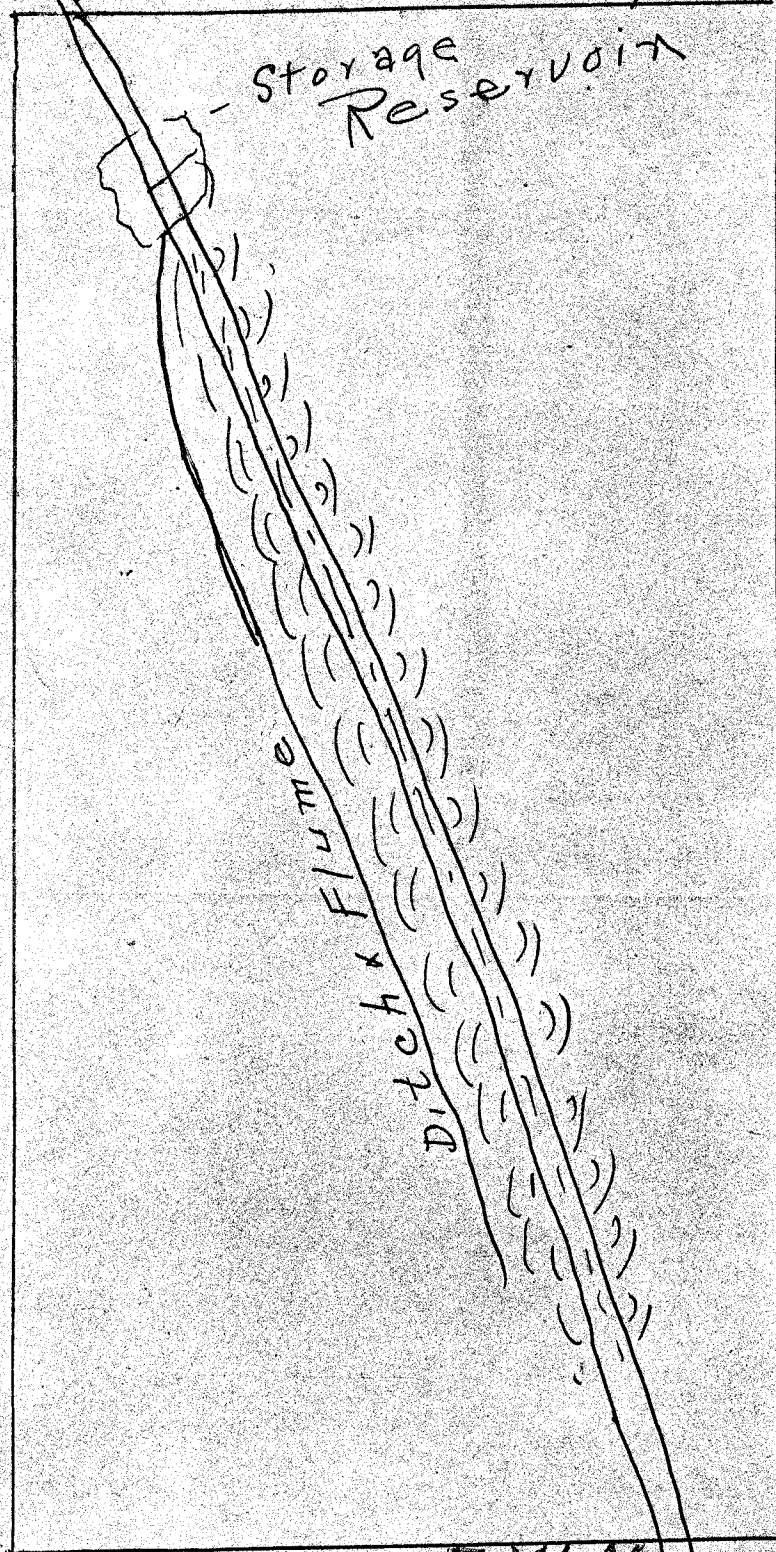

SR 34 EWM

Bridge Creek

RECEIVED
NOV 26 1934

app. No. 15492