


SECTION

TOWNSHIP 9 S, RANGE 4 E, W. M.

North

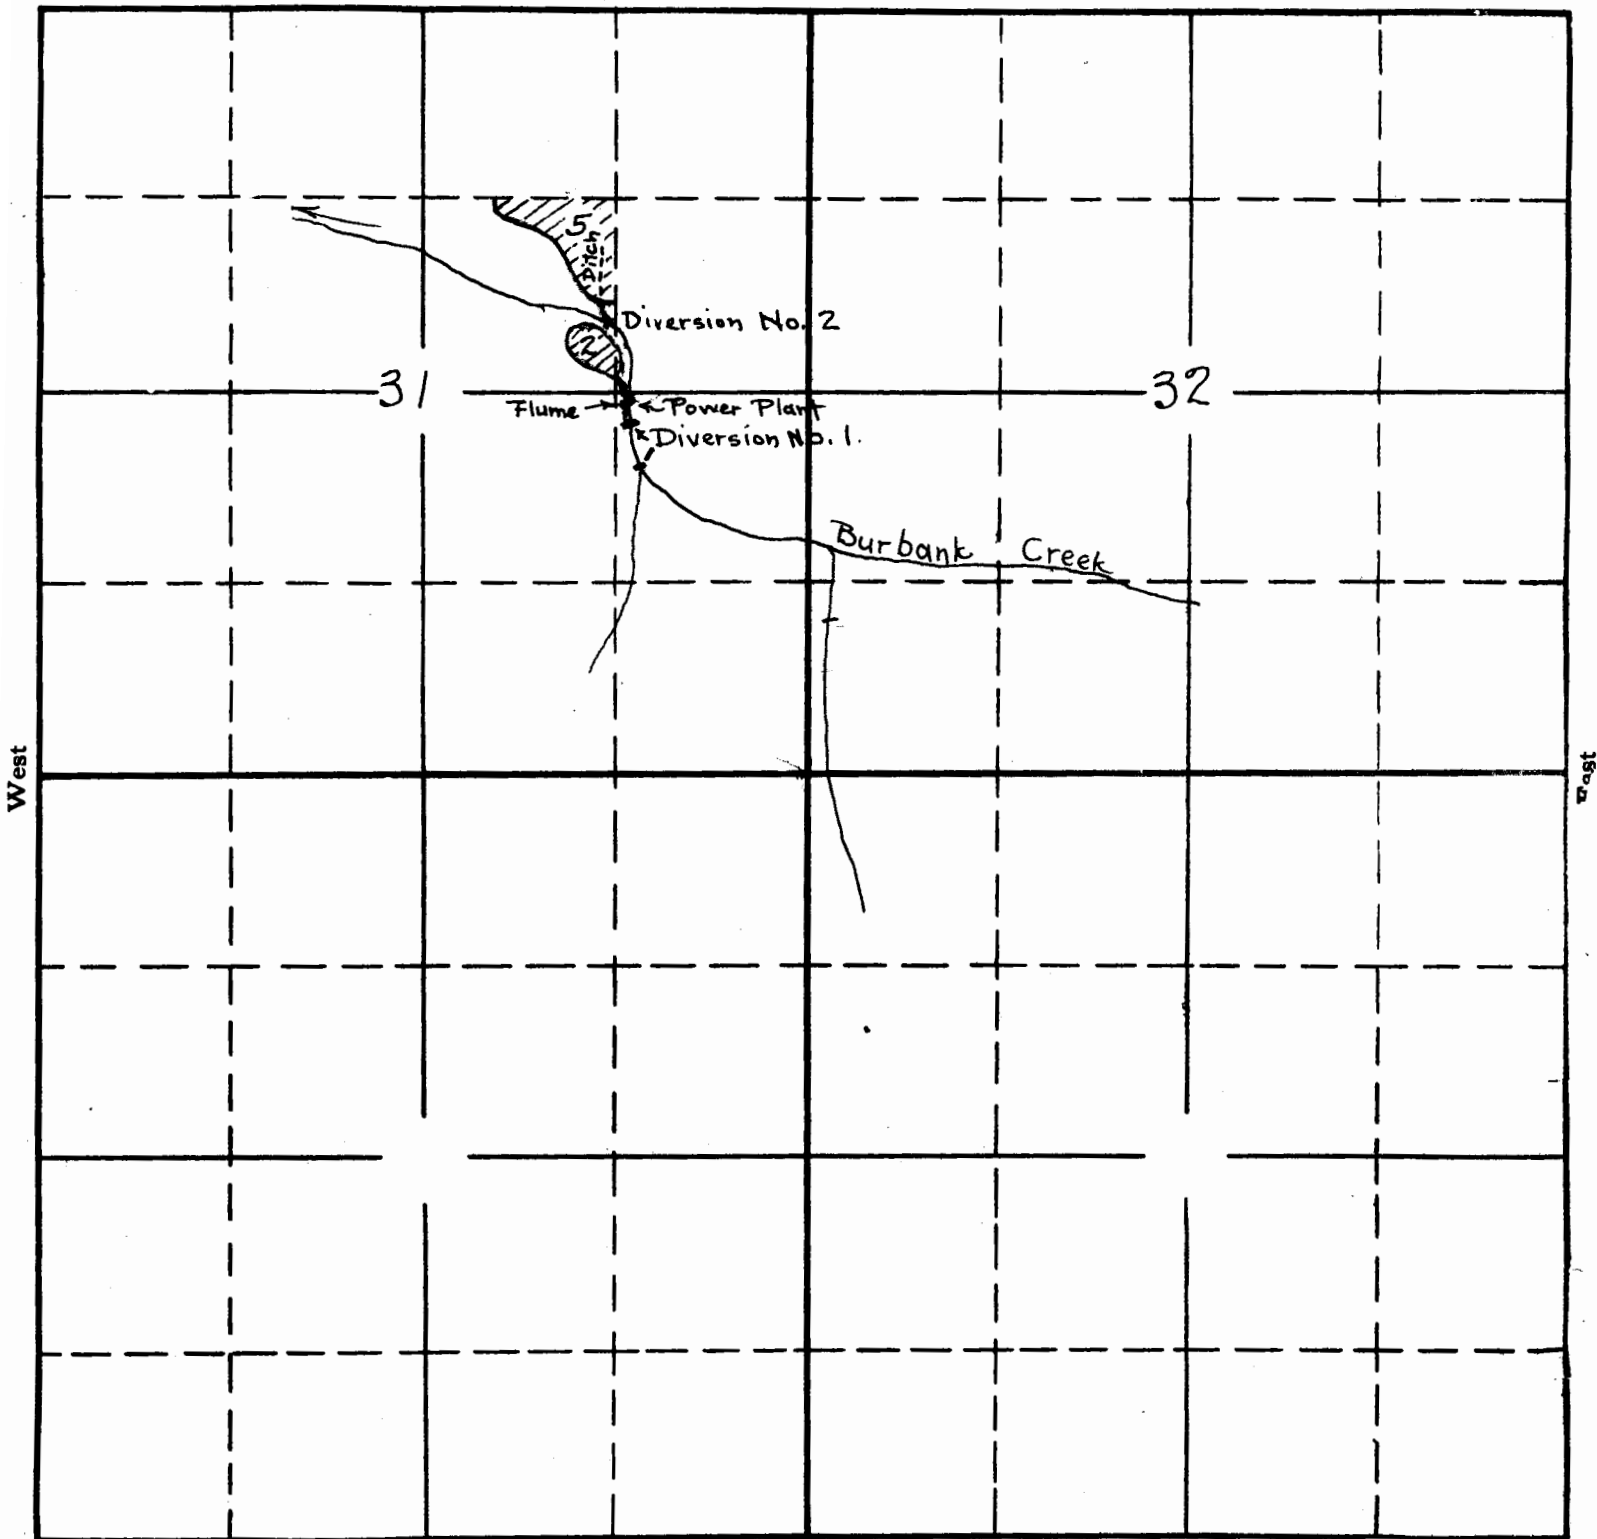

South

Amended Map
to accompany permit.
Filed Dec. 8, 1930.

APPLICATION No. 11303
PERMIT No. 8013