

11224


RECEIVED
MAR 20 1934

SECTION
9

TOWNSHIP 40, RANGE 19, W. M.

STATE ENGINEER

North

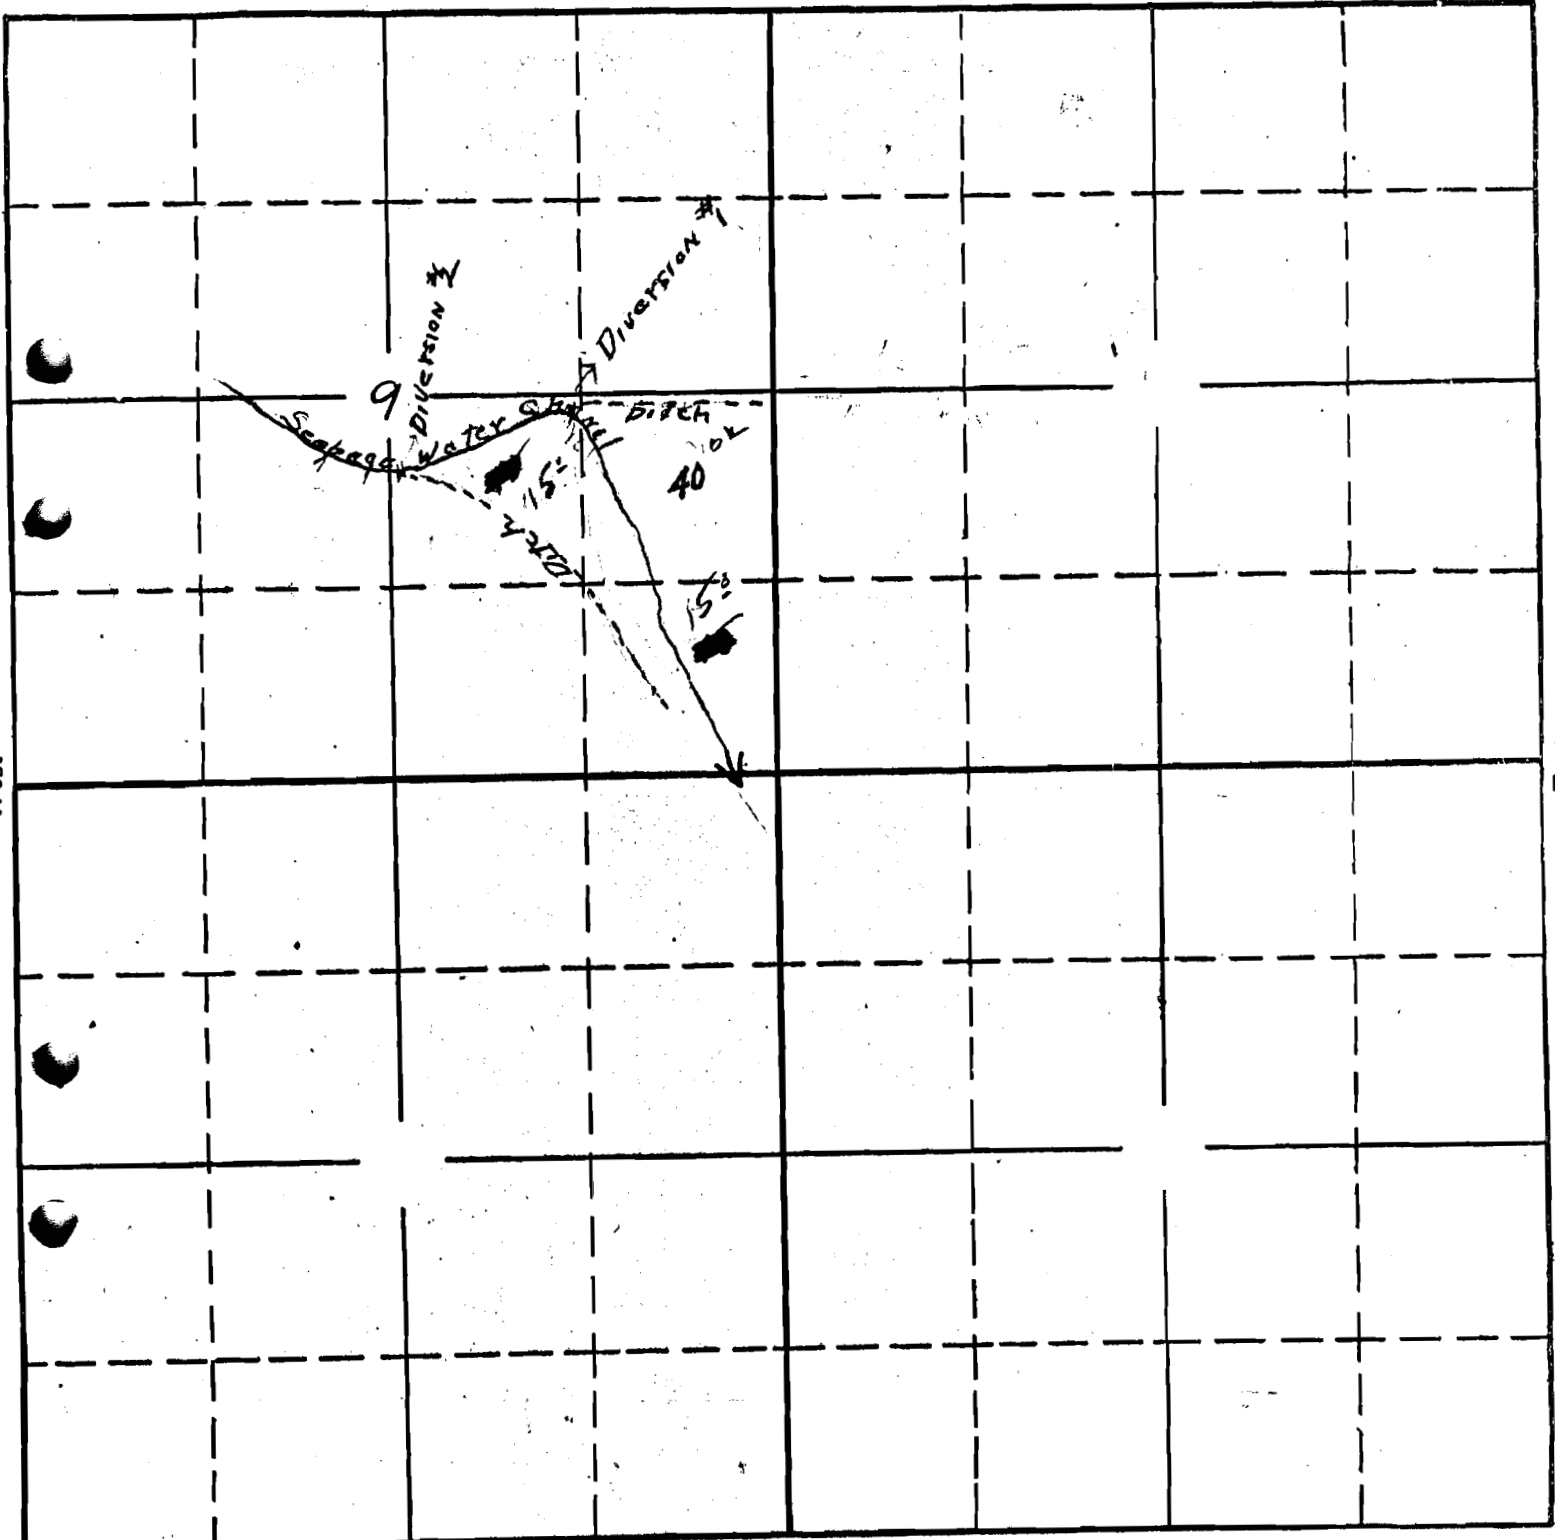

West

East

South

STATE ENGINEER

MAR 12 1934

RECEIVED

APPLICATION No. 15309

PERMIT No. 11224

40-19 ✓