


Sec. 21
22
27
28

Tp. 368
R. 248

11448
C#11268

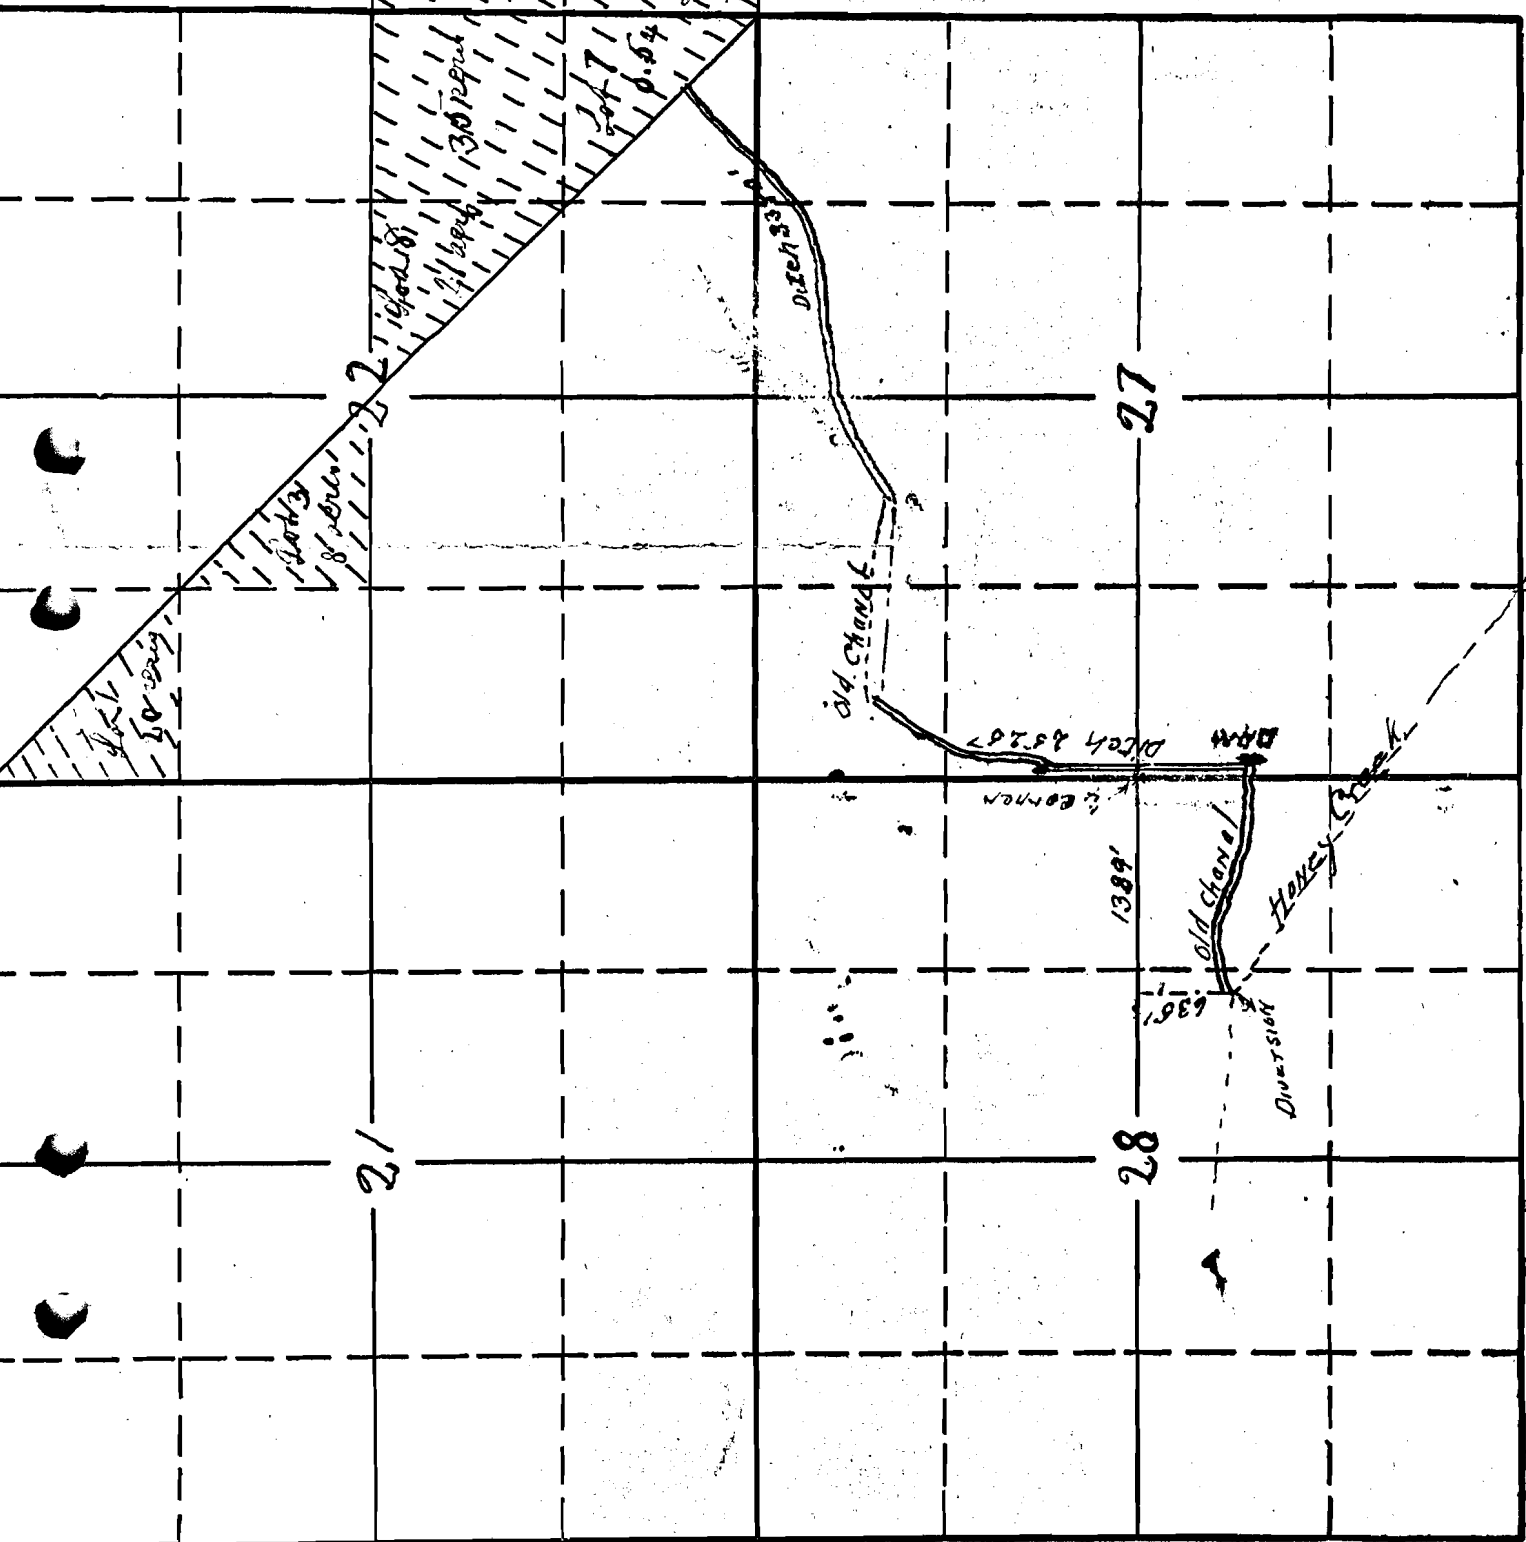

App. No. 15591
Per. No. 11448

36-24 ✓