


Sec. 32

Tp. 27

R. 3E

U-29

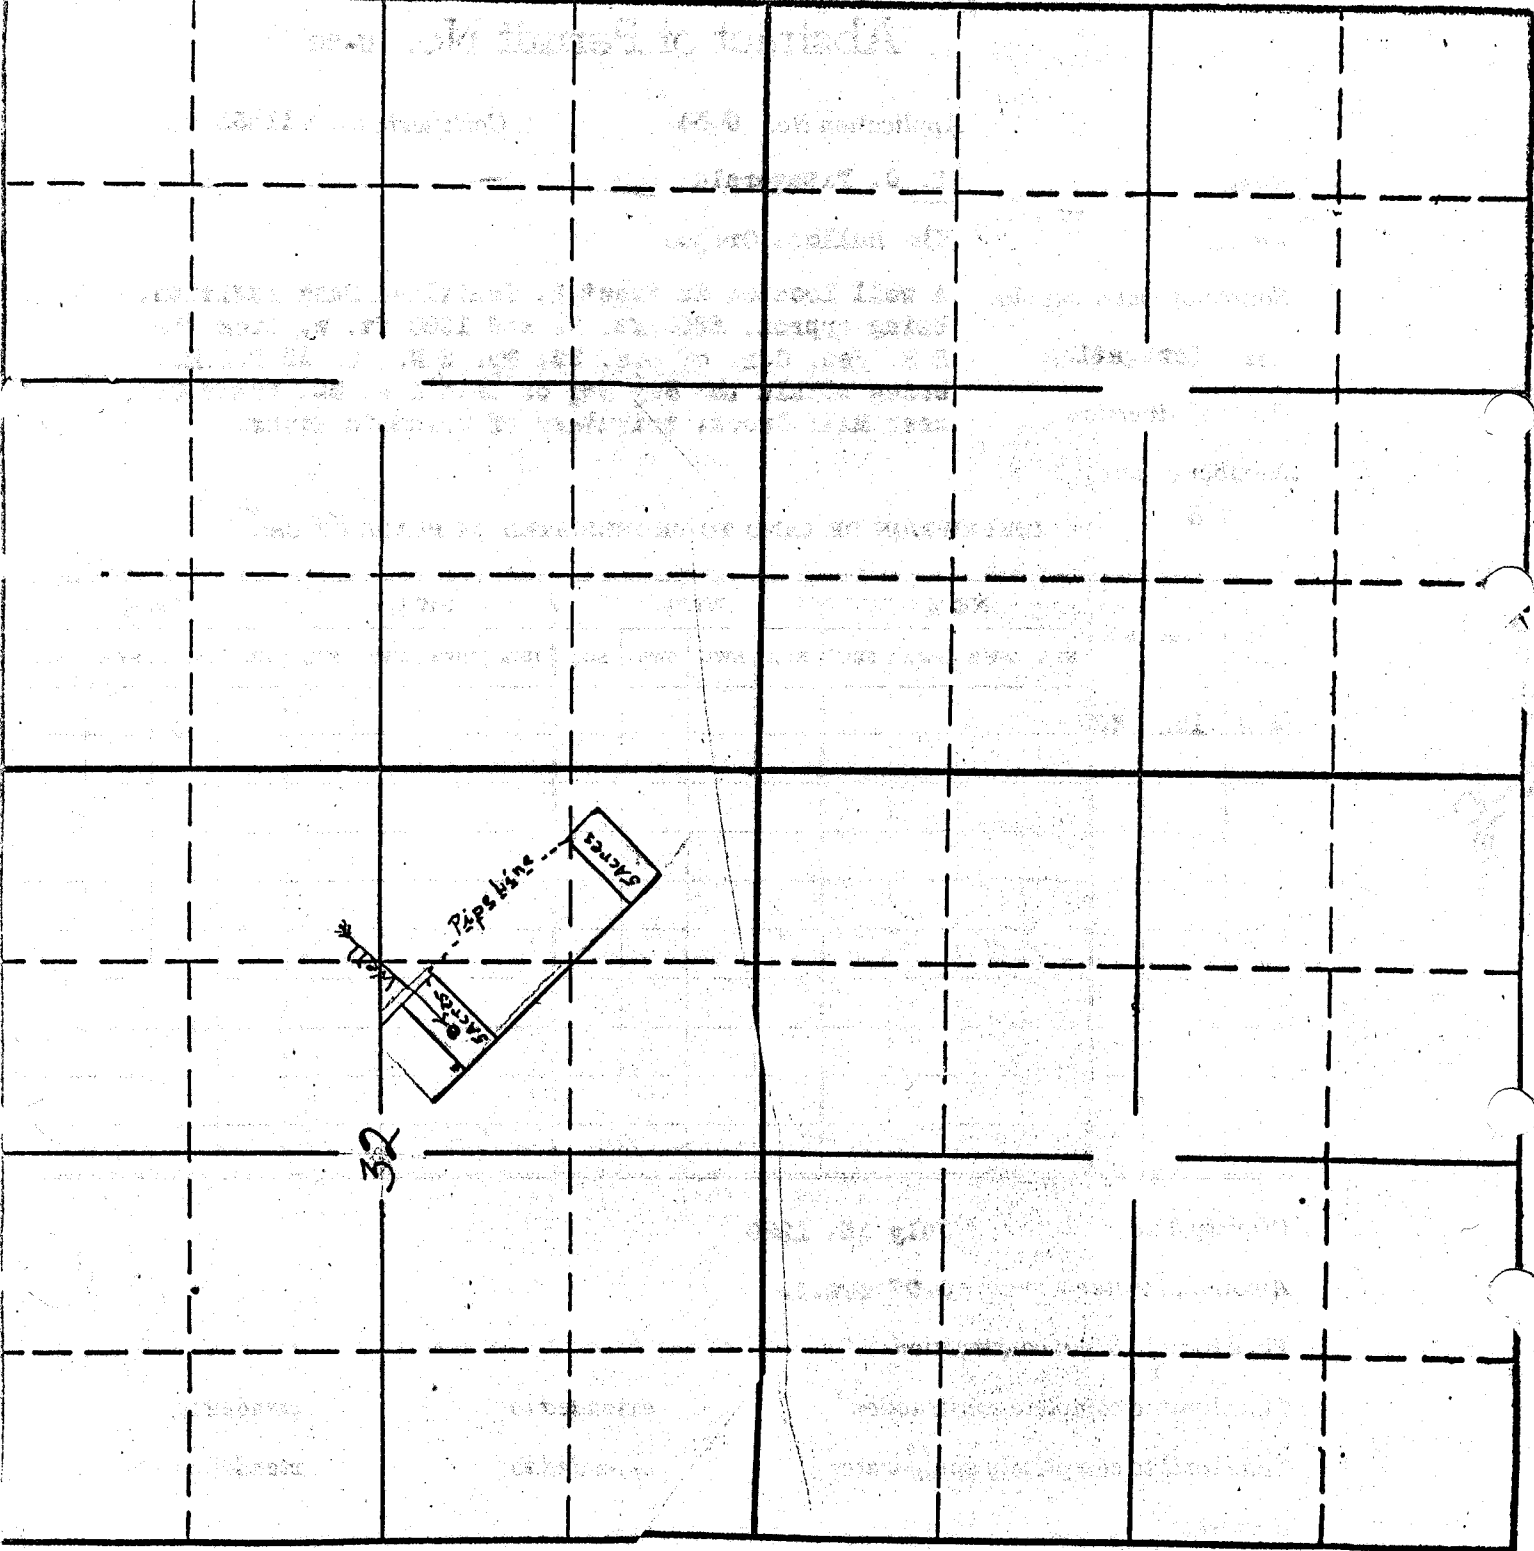

32

Application No. 21-34

Permit No. 21-29

21-29