


2 South

Range 11 E. W. M.

Sheet No. 1

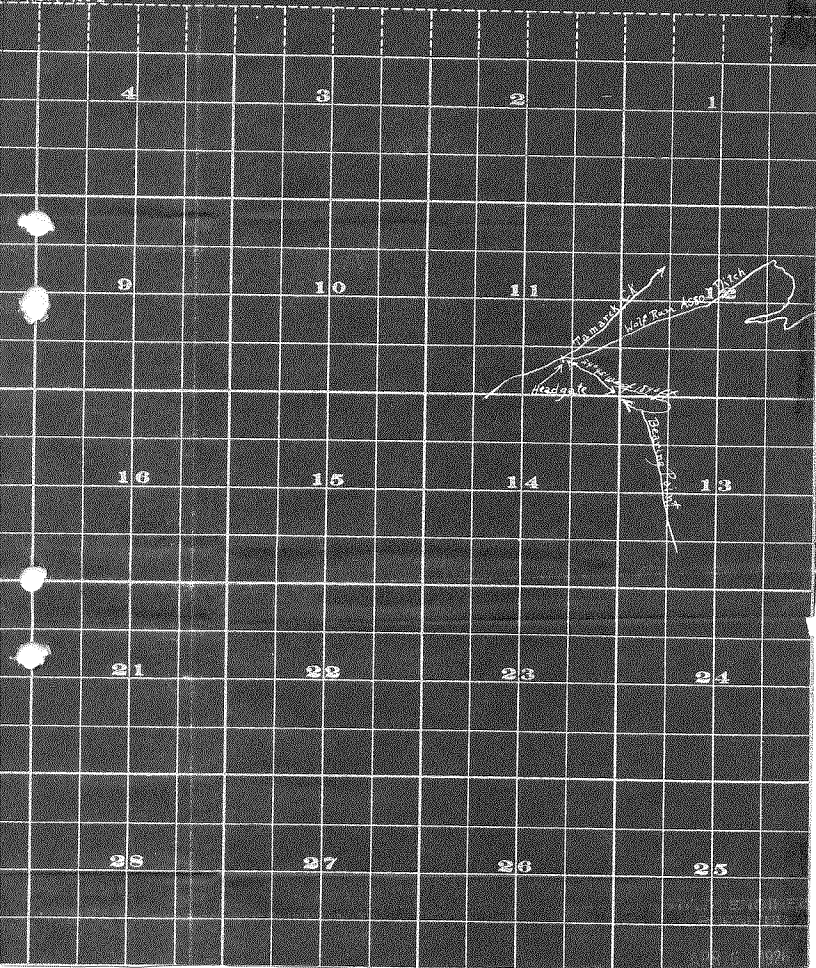

Township 2 South,

Ra

Map Harry A Johnson Ditch & Lands Sheet 2.

