




Range 26 E. W. M.

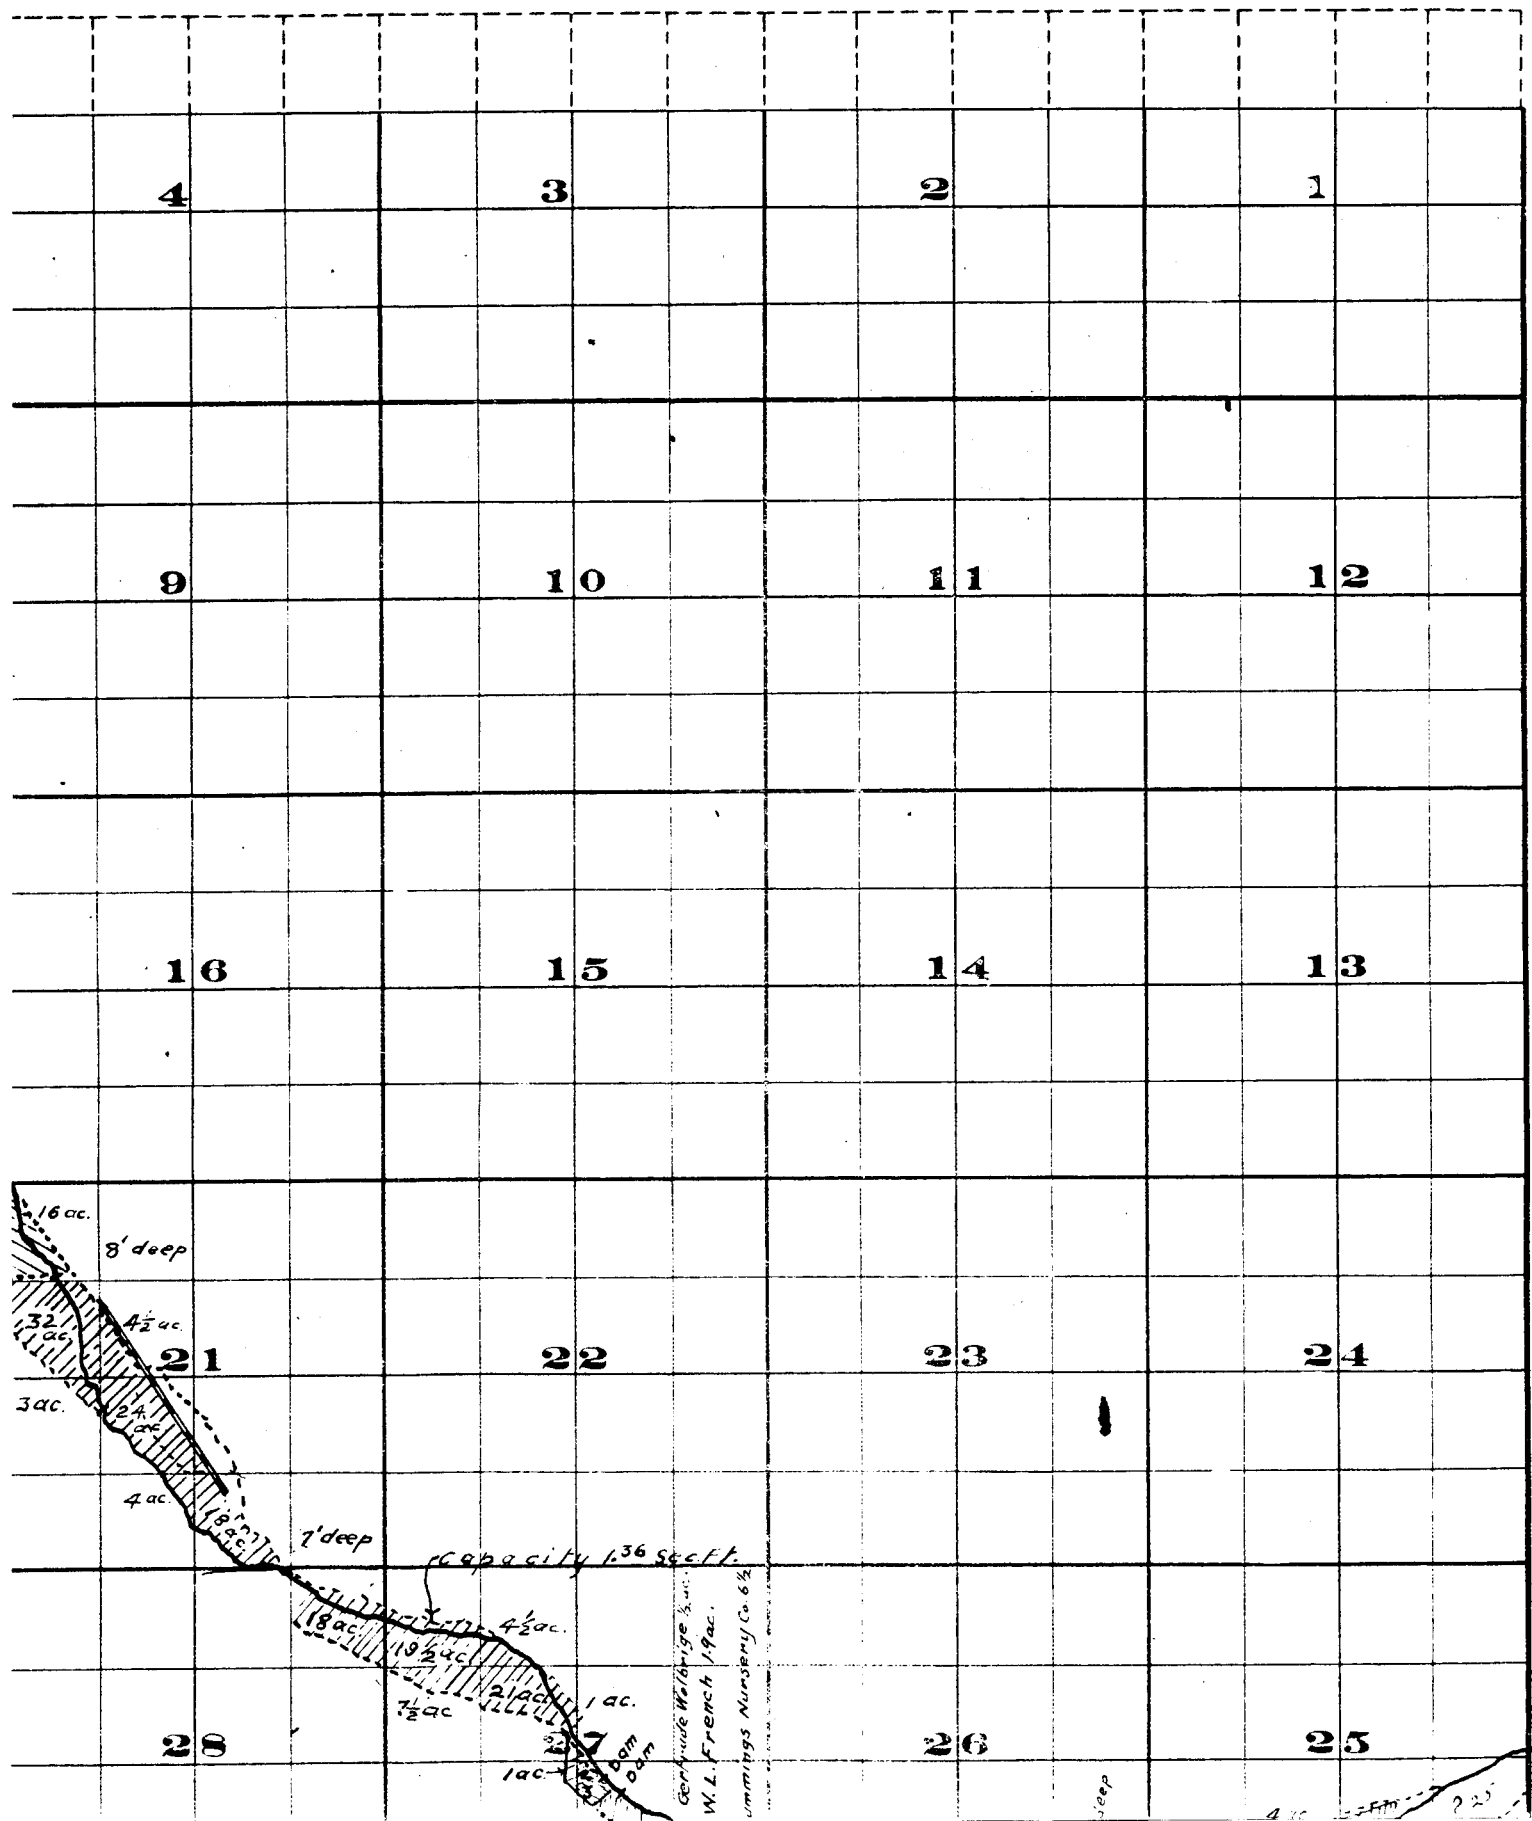

Township 2 S.

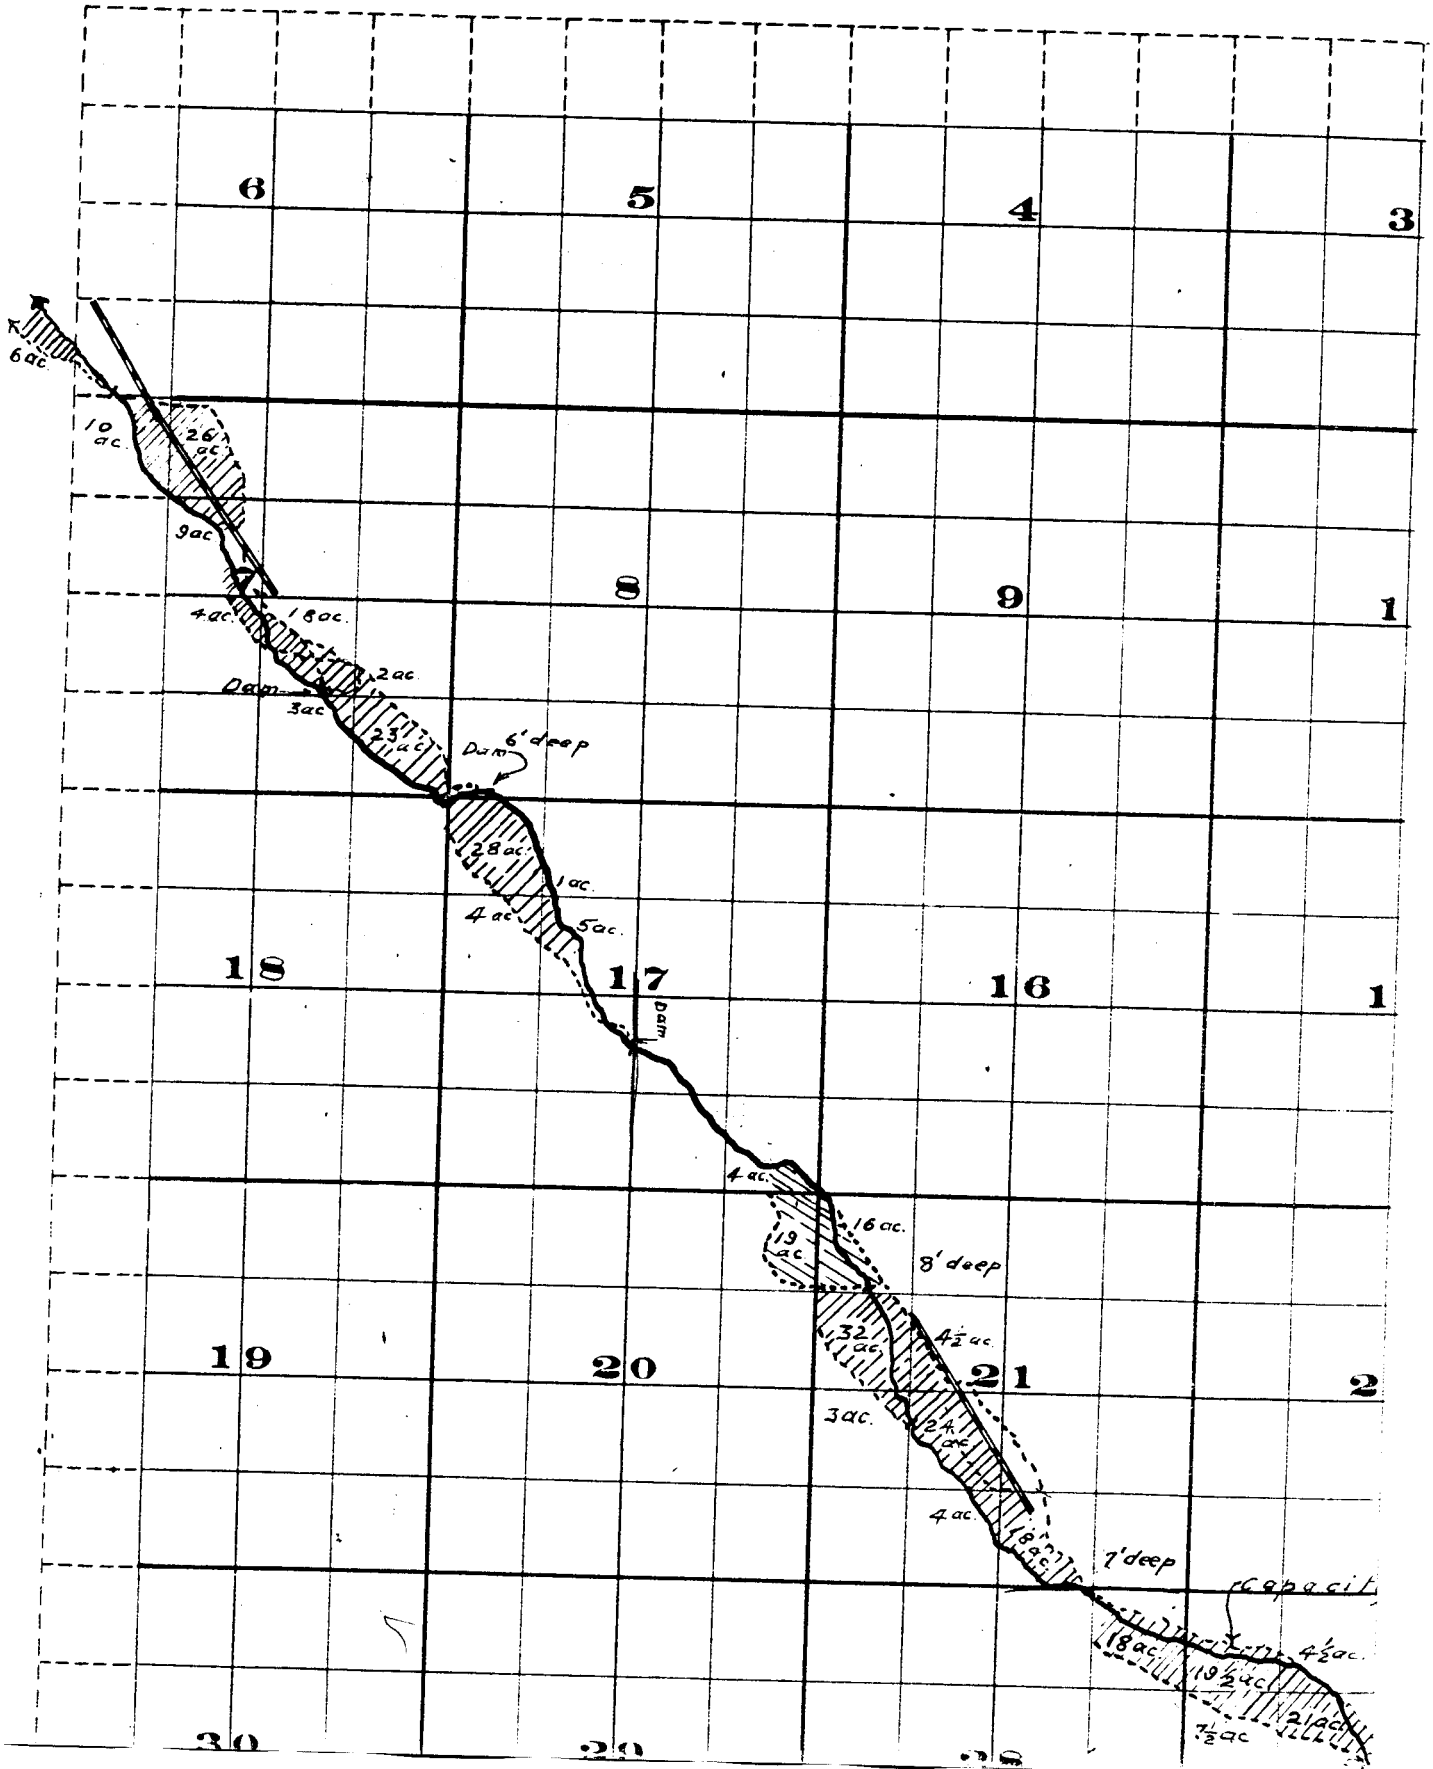

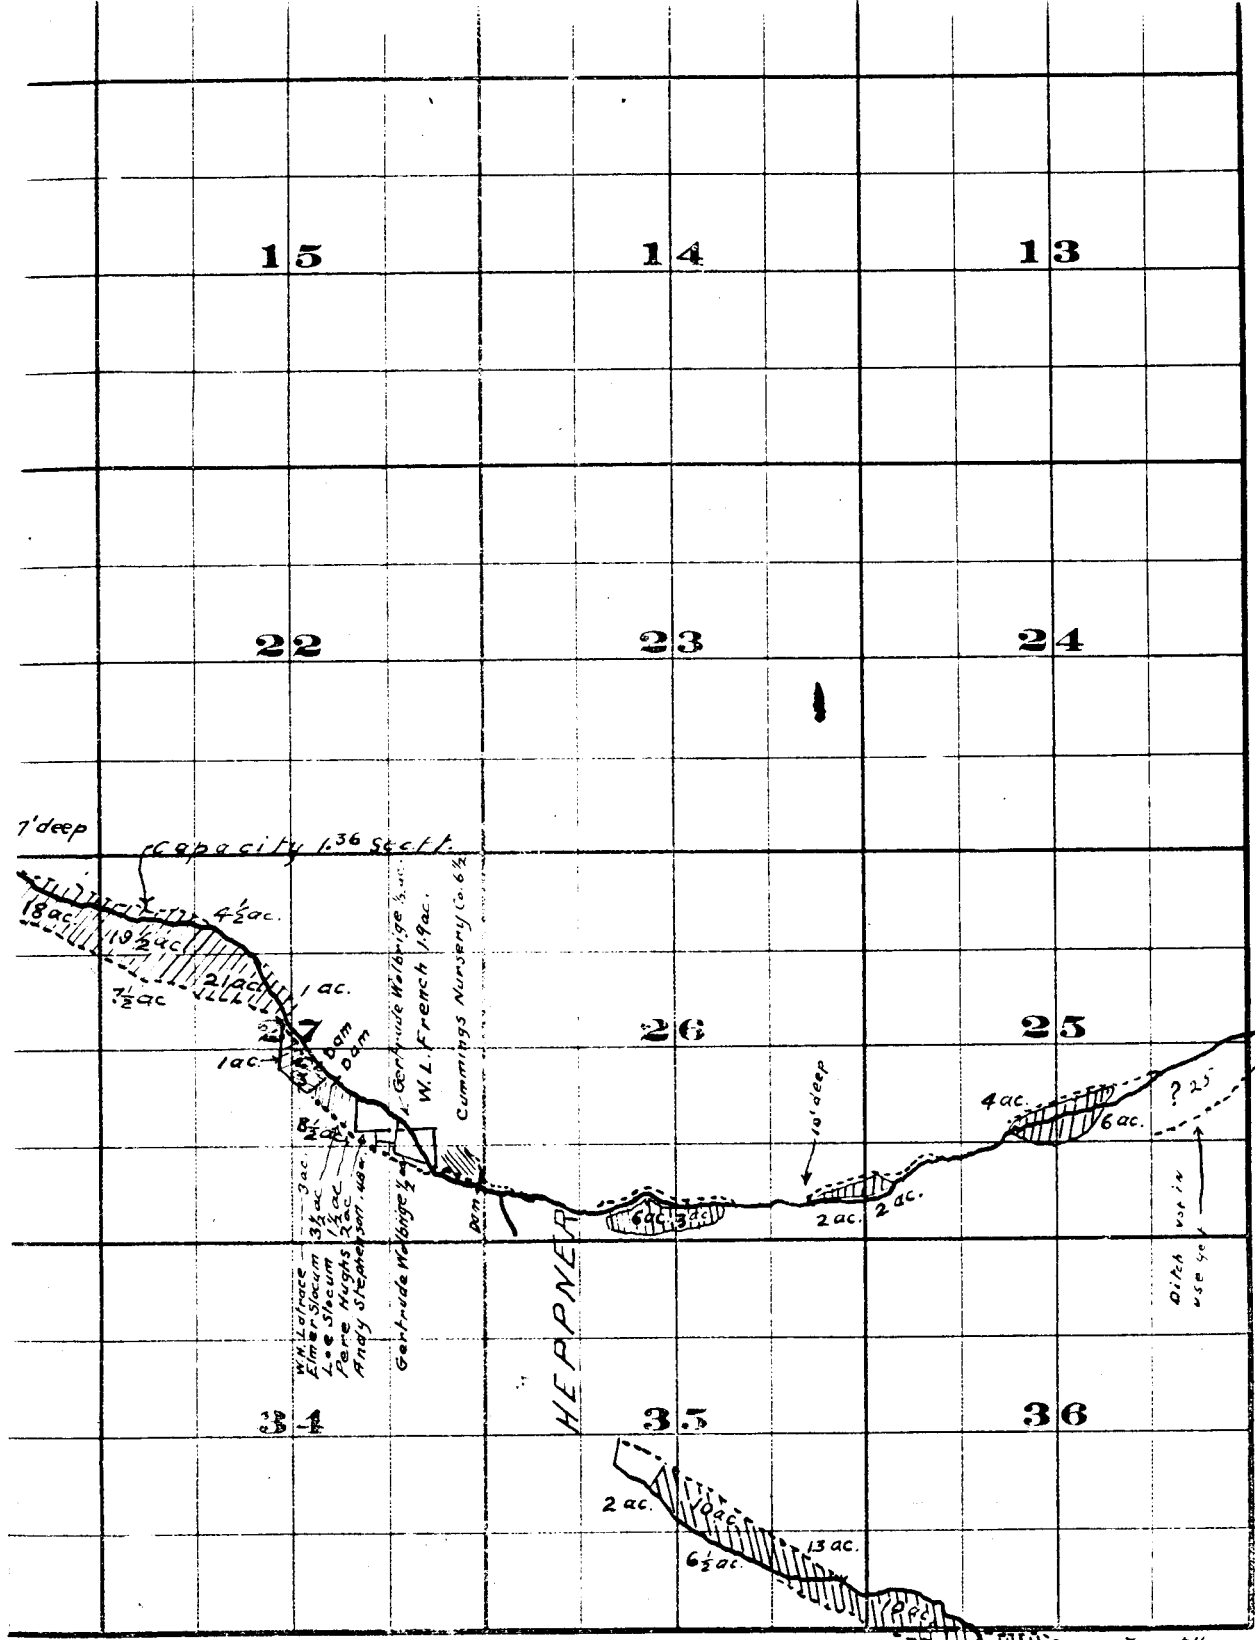

FROM OFFICE OF THE STATE ENGINEER

Willow Creek Adjudication



Part 35.26
25.26