


Per 10171
11300

Township No. 8, S. R. 31, E.W.M.

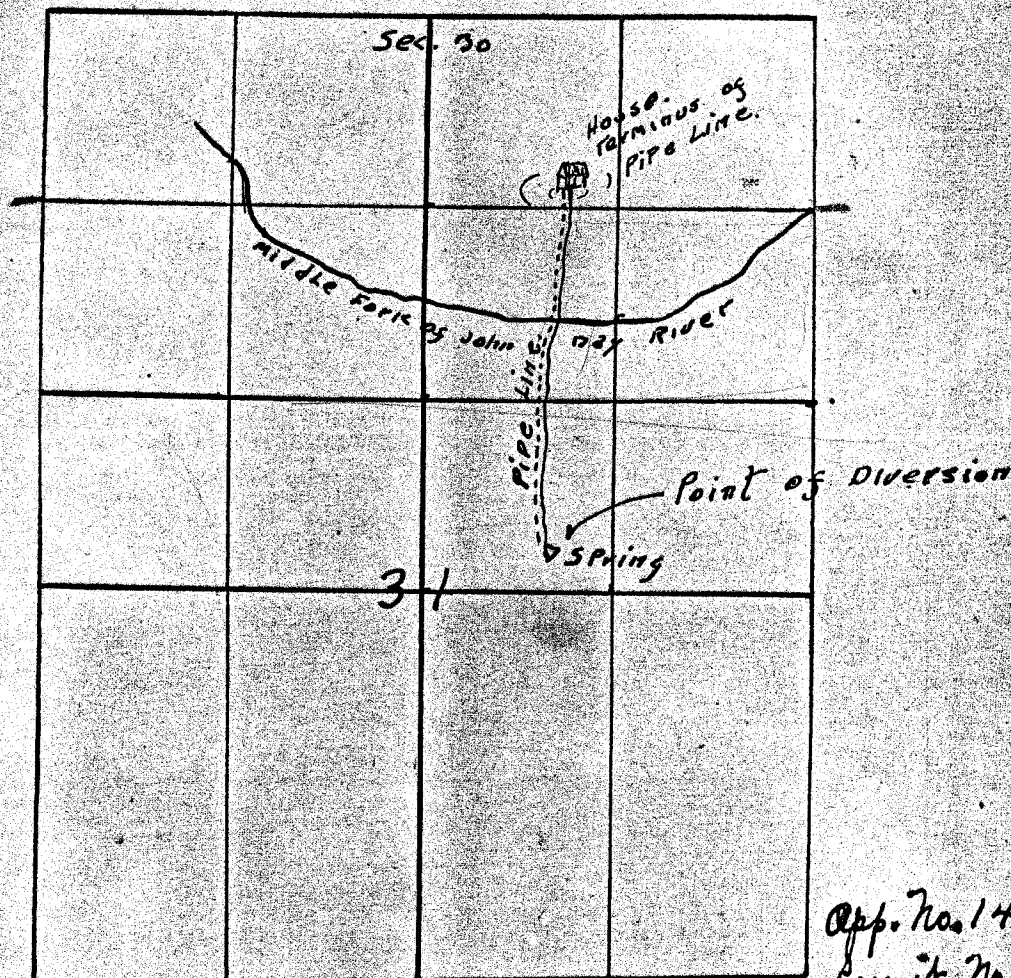

App. No. 14056
Permit No. 10171

Application of E Glen Powell
for

Appropriation of water from
Unnamed Spring Tributary of
John Day River - Grant County