


SECTION

TOWNSHIP 9S, RANGE 3E, W. M.

North

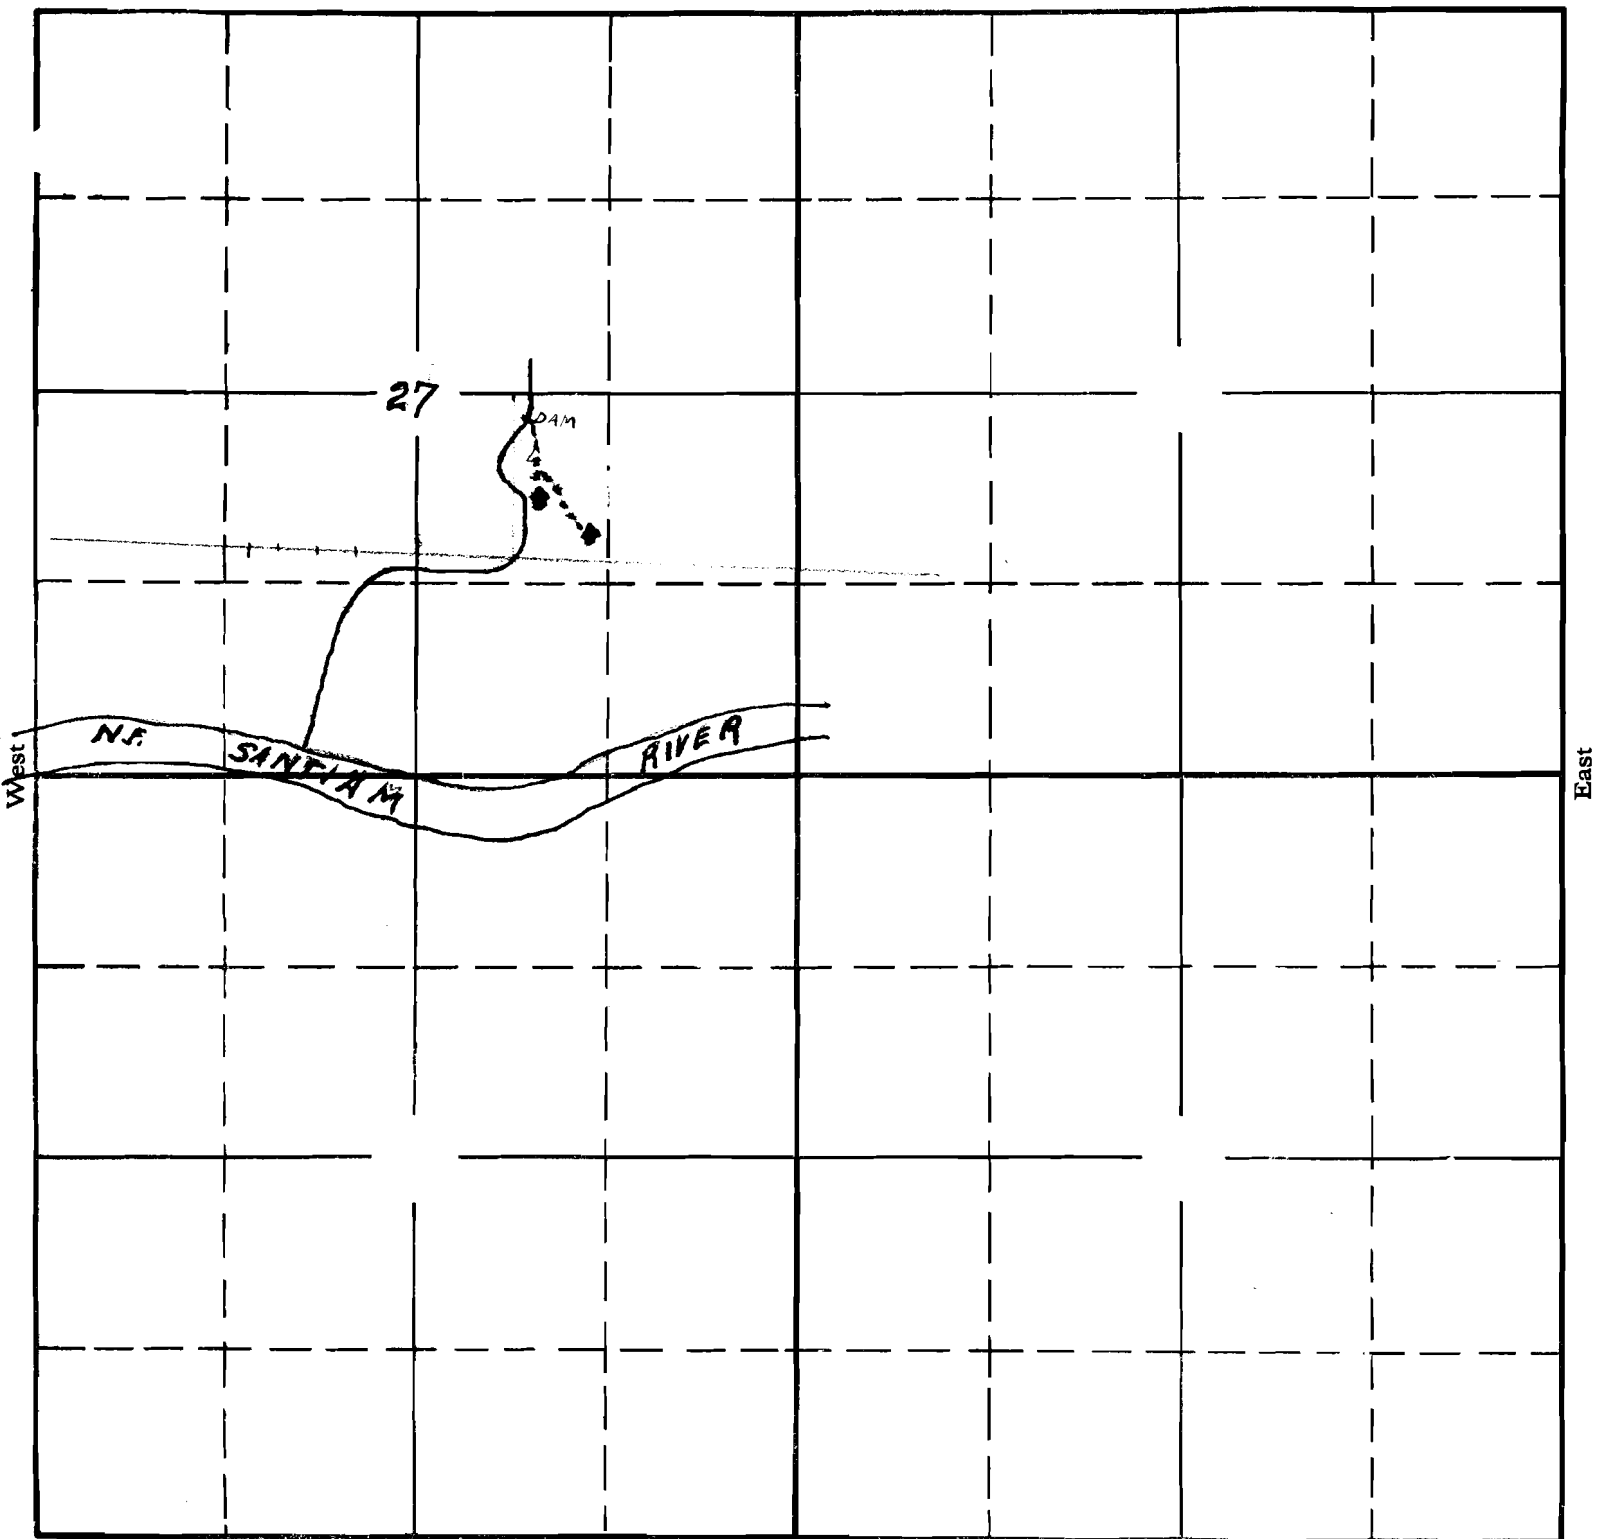

South

APPLICATION No. 15265
PERMIT No. 11184