


T. 21 S. R. 3 E. WM.

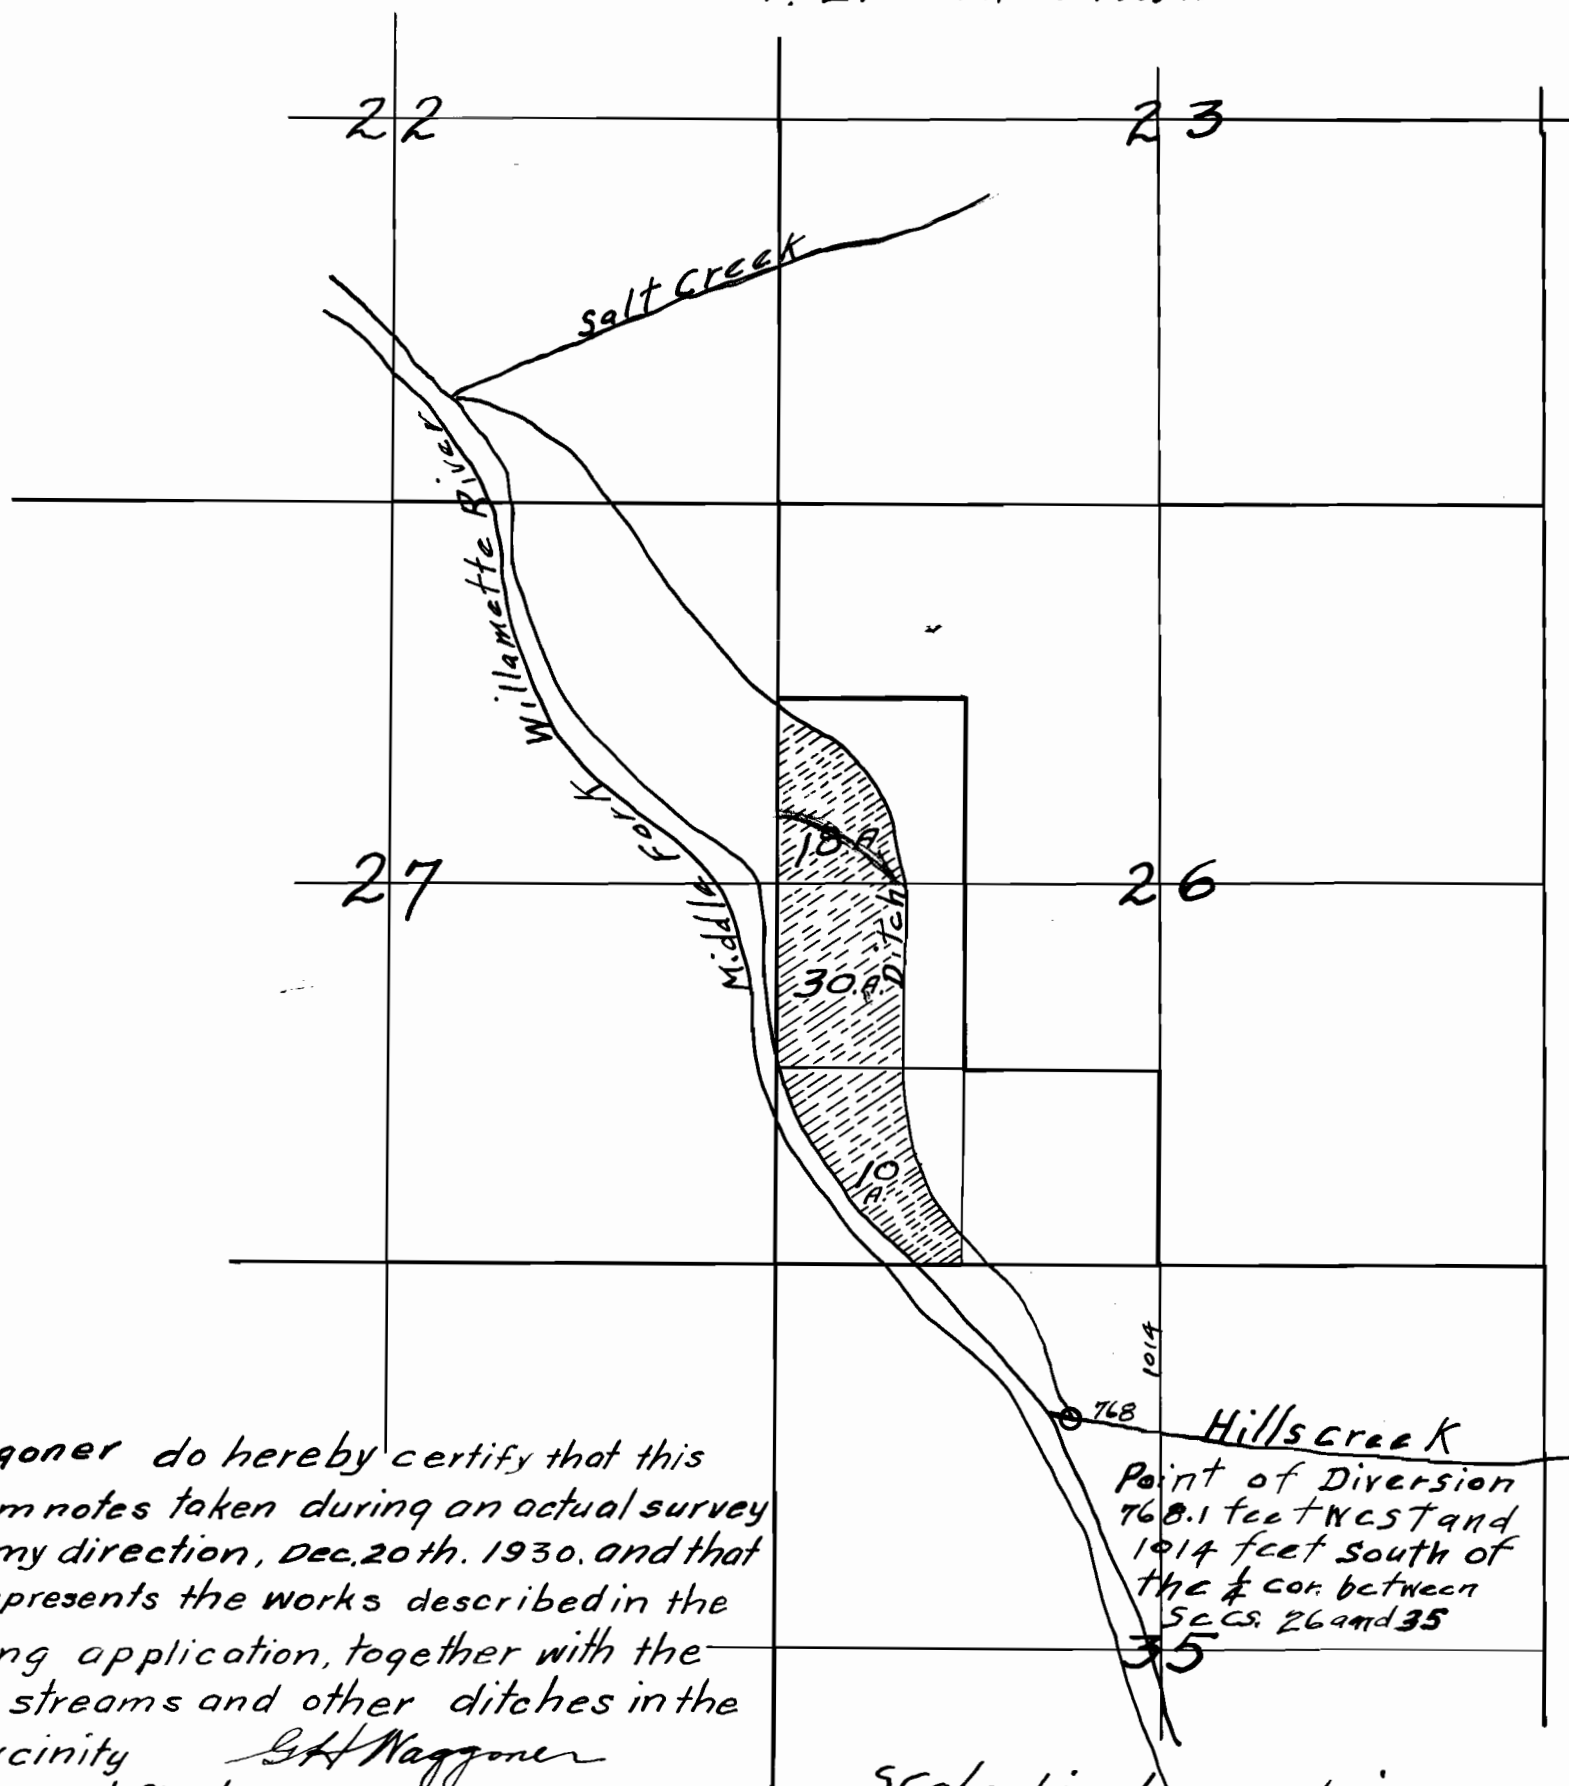

I G.H. Waggoner do hereby certify that this was made from notes taken during an actual survey made, under my direction, Dec. 20th. 1930, and that it correctly represents the works described in the accompanying application, together with the location of streams and other ditches in the immediate vicinity

G.H. Waggoner  
Engineering Certificate, Oregon No. 954

Dated Dec 31st 1919,

Scale 1 inch = 20 chains

13890

9999