


SECTION

10471

MAP  
11370

TOWNSHIP 55, RANGE 3W, W. M.

North

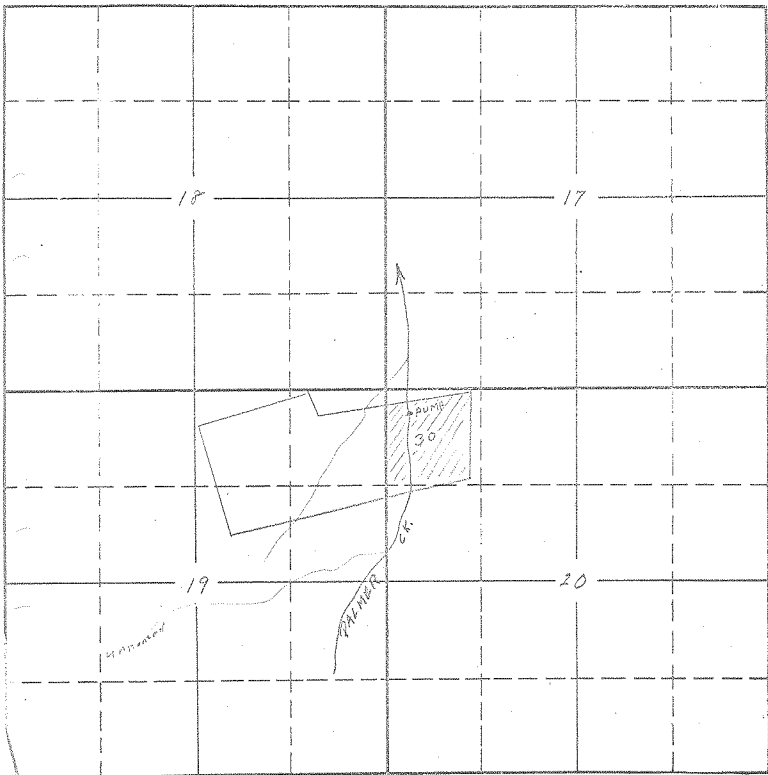

Corrected map filed -  
11/2/35 - B

South

APPLICATION No. 14451  
PERMIT No. 10471