


Sections

11254
11392

19
20
29
30

Township 9 S. Range 35 E W.M.

North

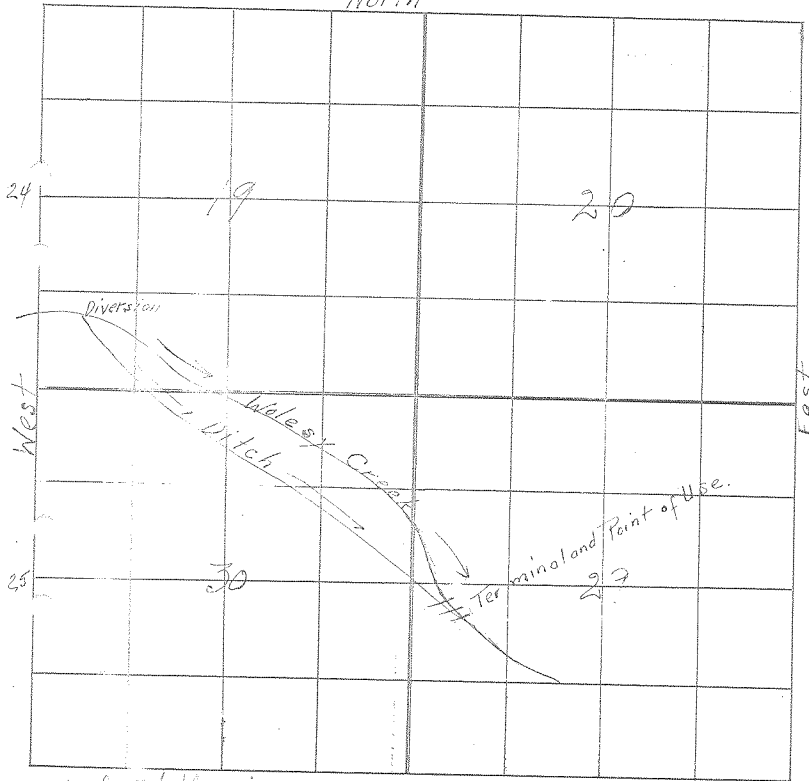

See layout of lot points
attached to proof -

South

Application No. 15334
Permit No. 11254