


SECTION
24

15220
1792
1164

TOWNSHIP 9 N, RANGE 10 E, W. M.

North

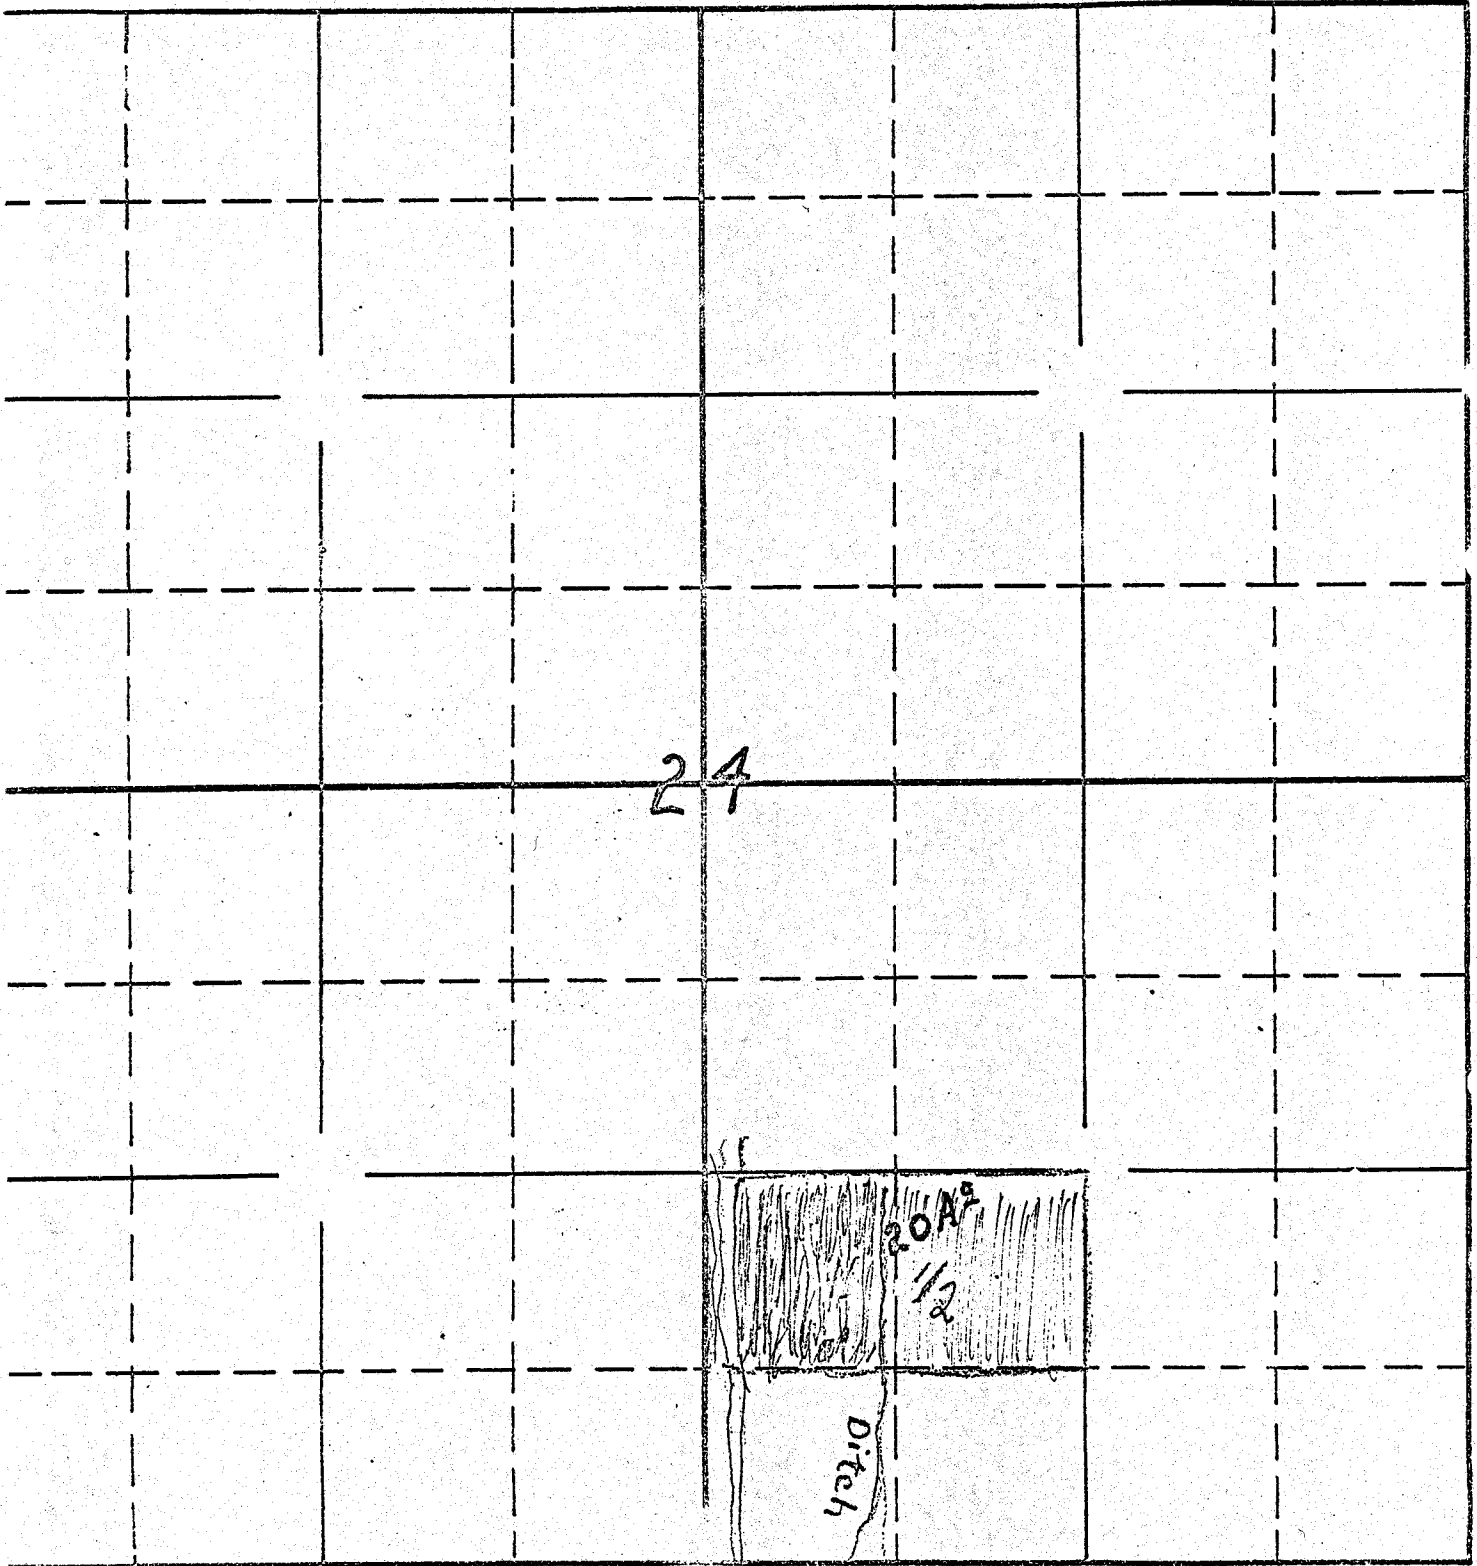

East

24

20 A 1/2

Ditch

South
Neal Creek

APPLICATION No. 15782
PERMIT No. 11641