

SECTION

5

6

7


8

TOWNSHIP 5 S, RANGE 2 E, W. M.

AUG 23 1935

STATE ENGINEER

North

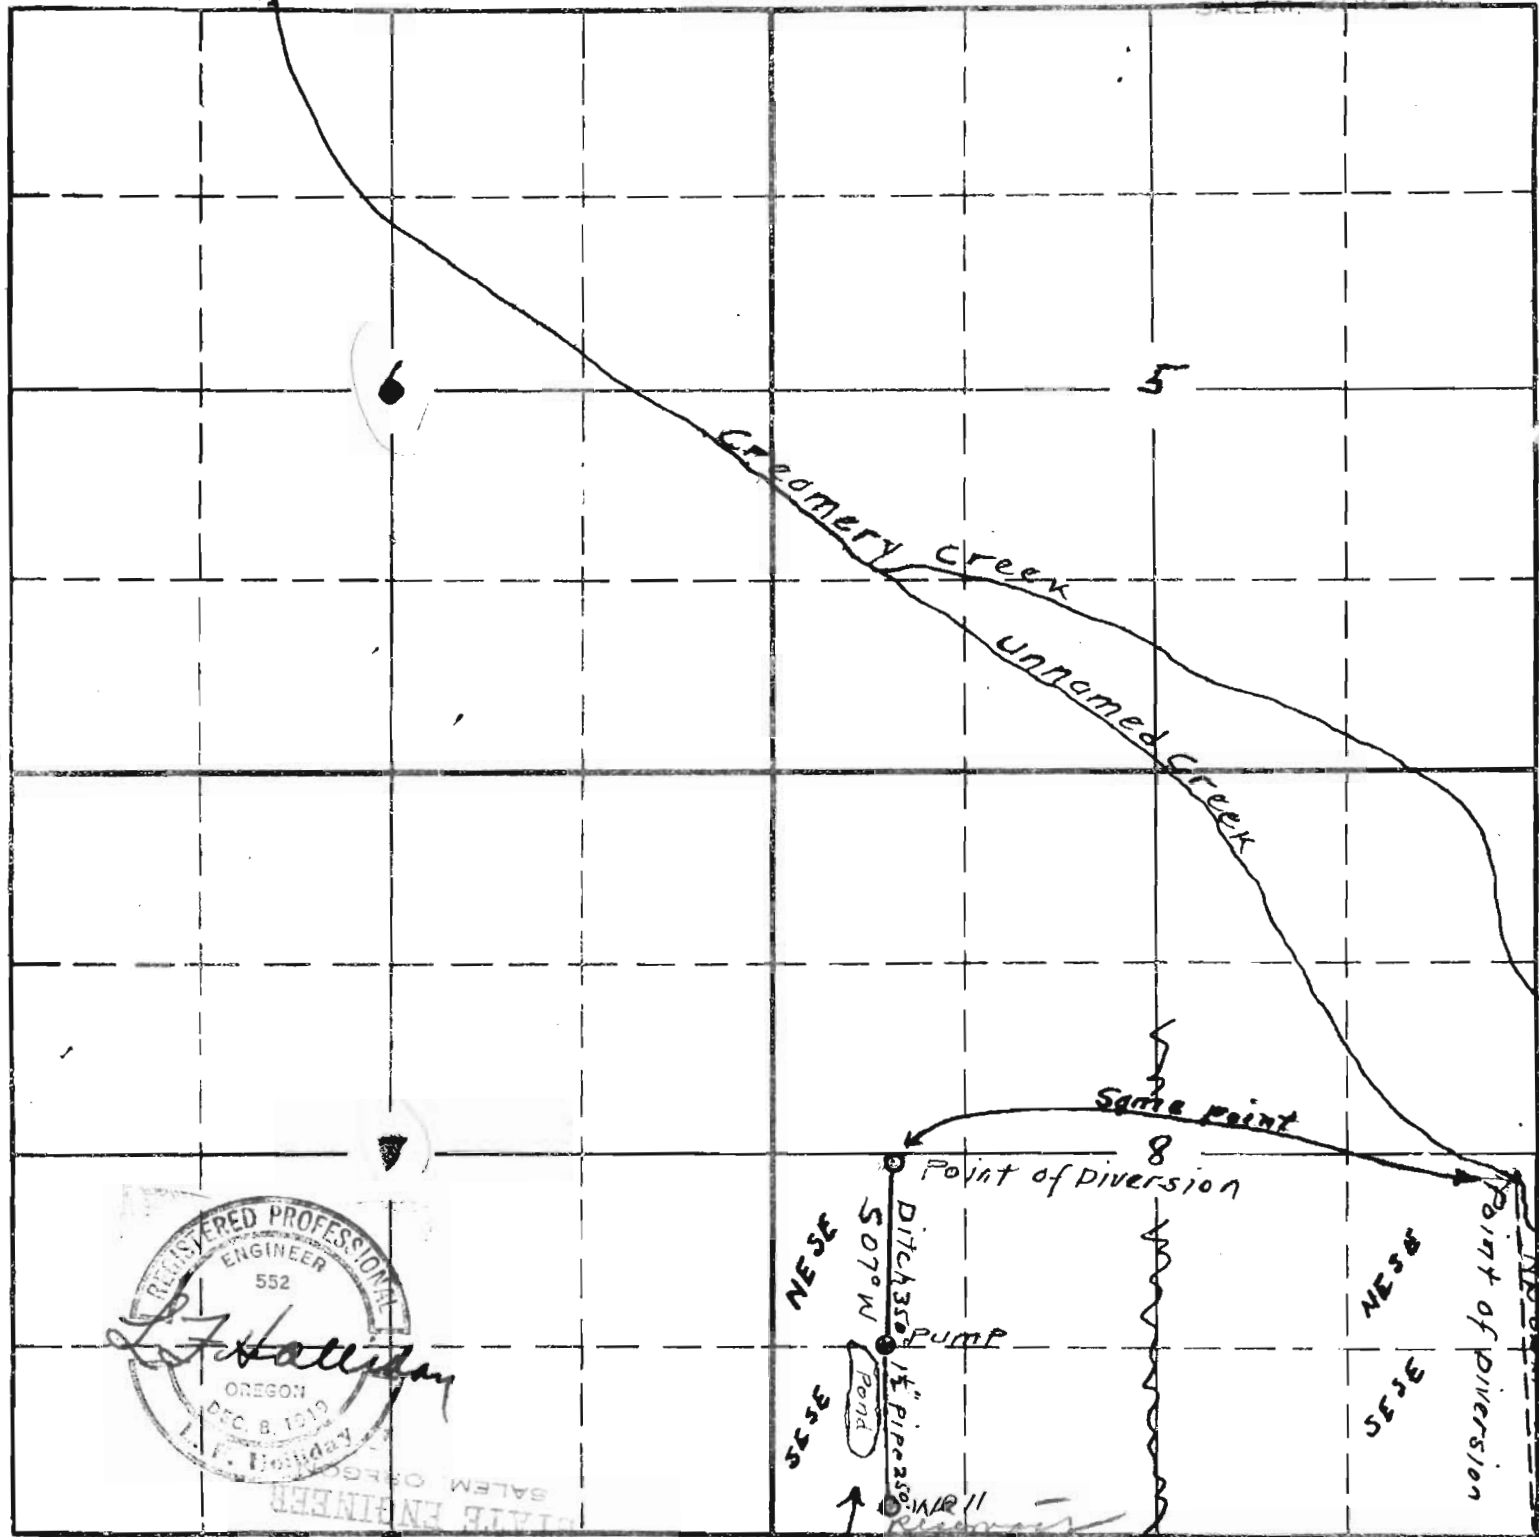

REGISTERED PROFESSIONAL
ENGINEER
552
L. F. Holliday
OREGON
DEC. 8, 1919
L. F. Holliday
SALEM, OREGON

RECEIVED
AUG 23 1935

South
Moved to show
works

2-324-16009-OK
APPLICATION No. 16009
PERMIT No. 11890