


Sec. 35

10395

Tp. 3. N

R. 10. E

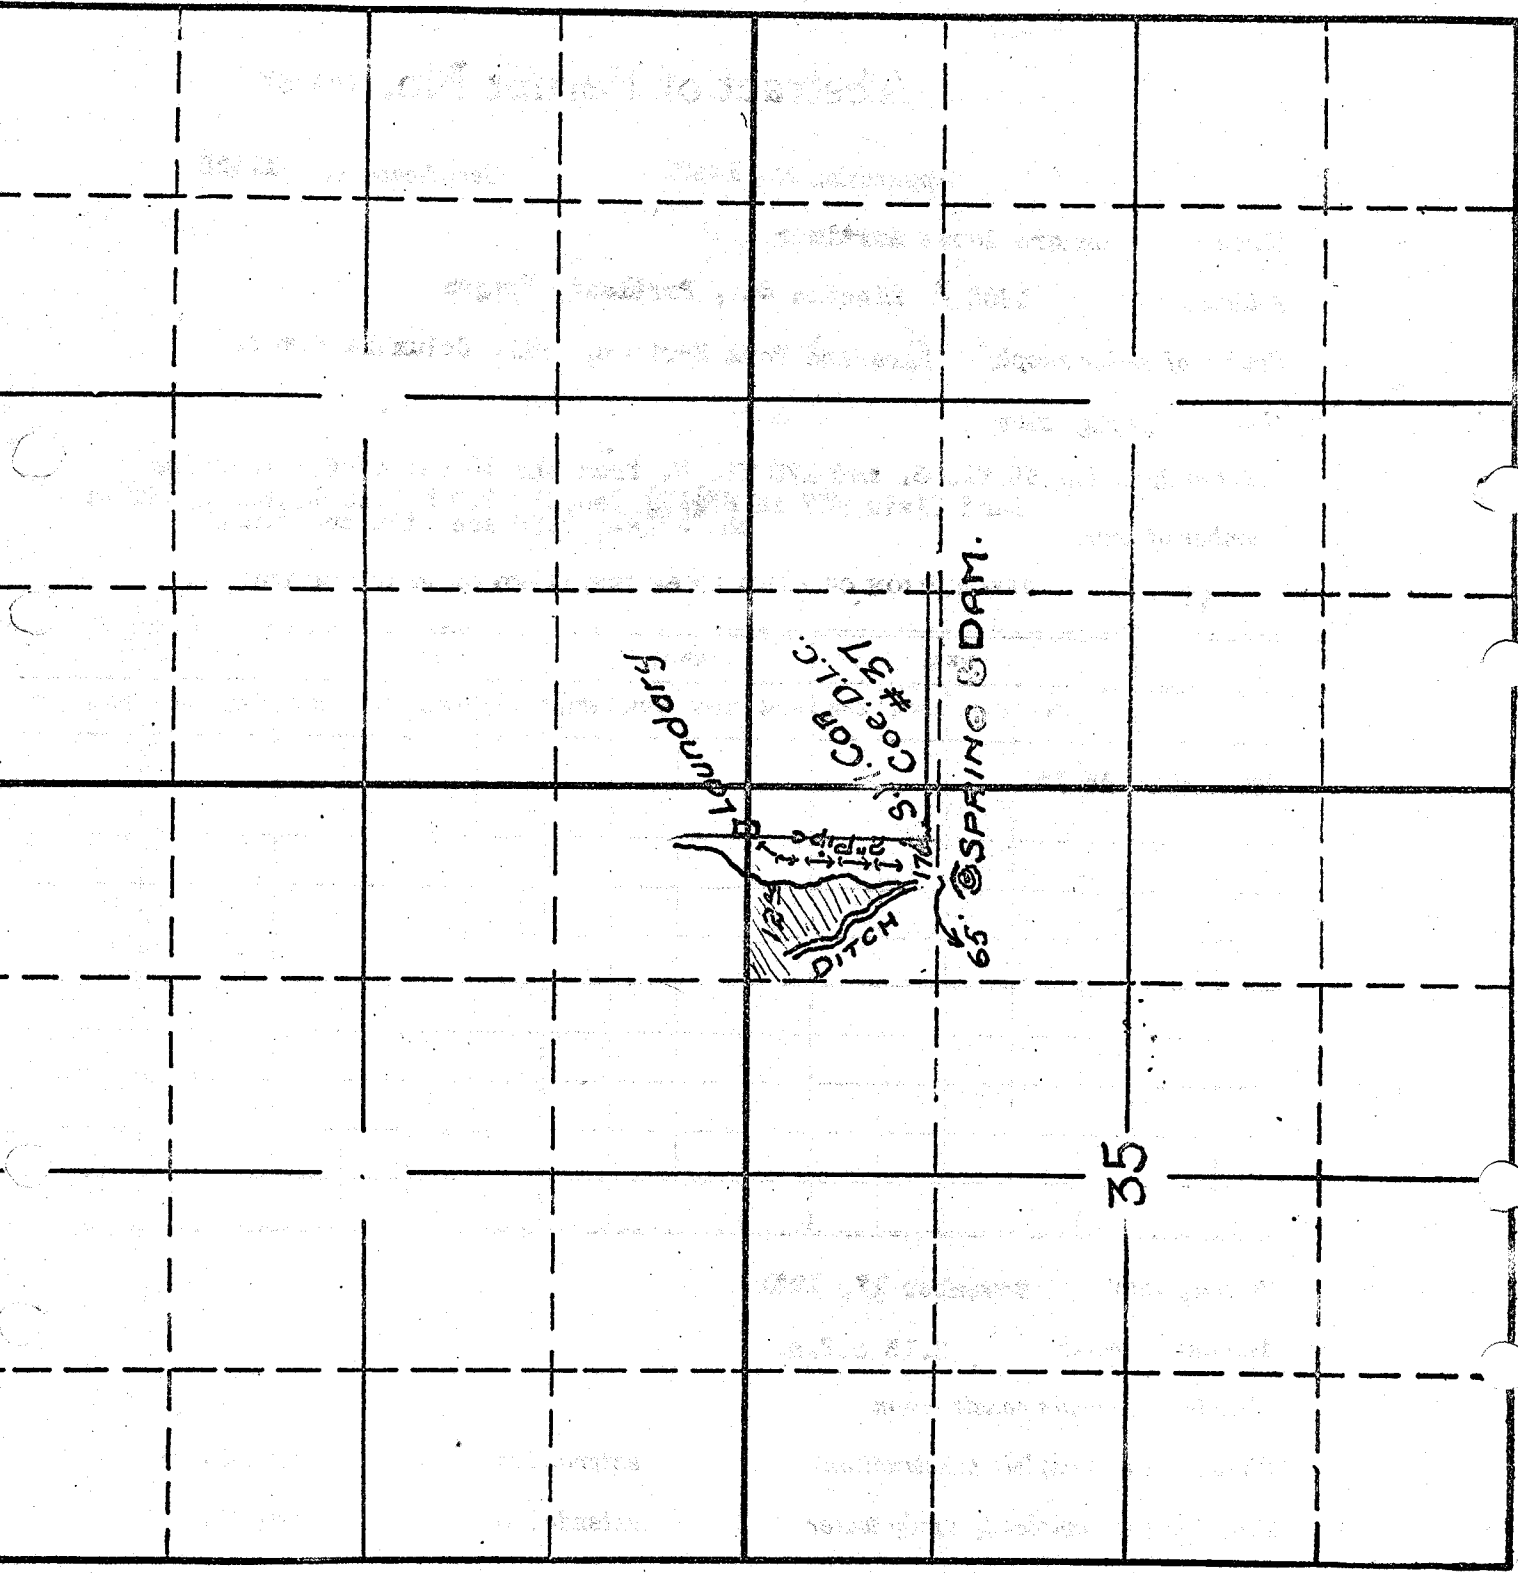

Application No. 14421  
 Permit No. 10593