


44600
Sta 21-165-7E

Retrospect
from State Highway
Survey of McKenzie Hwy.
& is only approximate

700'




Compass Traverse
**PROPOSED - WHITE - BRANCH
WATER - SYSTEM**
Including tie to McKenzie Highway
Scale 1"=100'

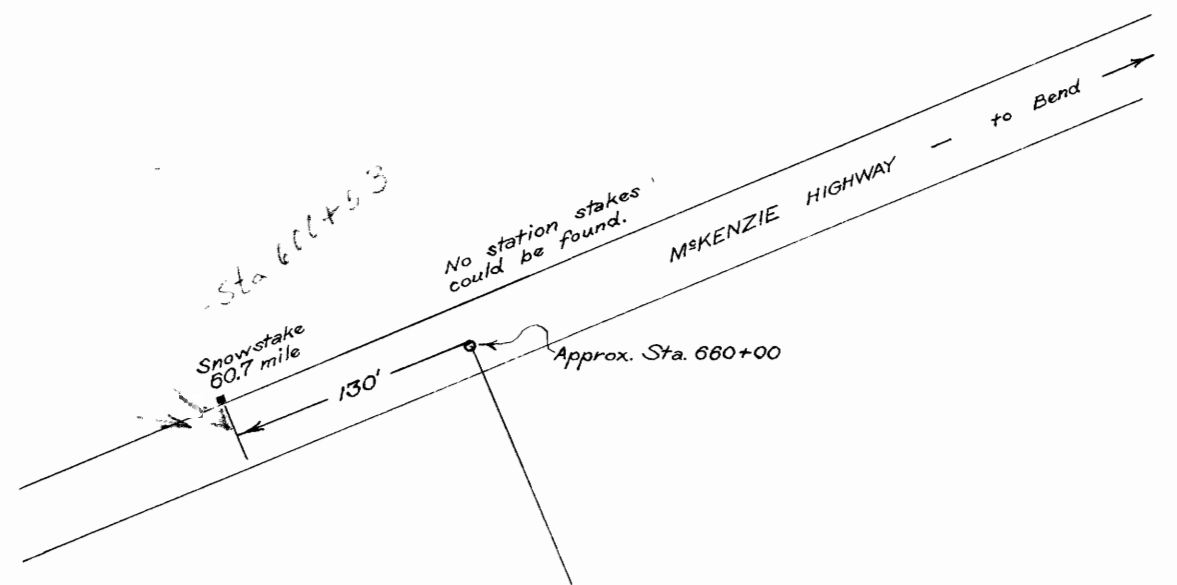

N 63 1/2° W
230'

N 17° W
80'

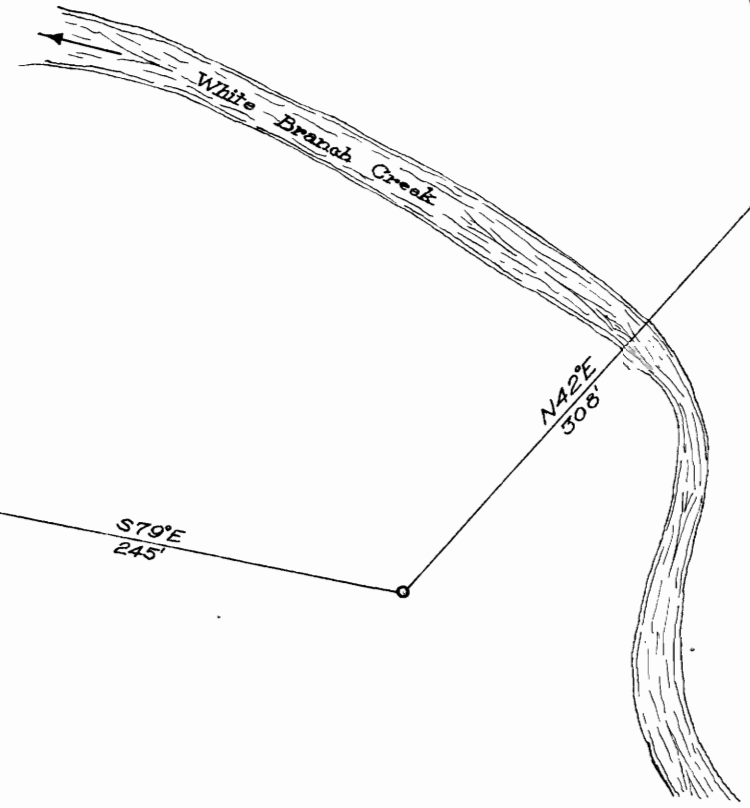

Beginning of Traverse to Highway to tie.

S 88° E
142'

N 68° E
122'

S 79° E
245'

10+44 Winter Sports Shelter
Place of use.

9+20

8+04 Drain Valve

N 30° E
738'

SKI SLIDES

0+68

0+00 Point of Diversion

Center of
curve - 21-165-7E

App. No. 16155
Per. No. 11970

2-28-16155-15