


MAP SHOWING  
CRANBERRY BOGS ACTUALLY WATERED  
FROM THE LYONS RESERVOIR  
scale :- 1 inch = 400 feet.

Total Area Watered 14.28 Acres.

DATA ON LOCATION AND  
AREAS OF MARSHES OBTAINED  
IN ACTUAL SURVEY APRIL 29, 1936.



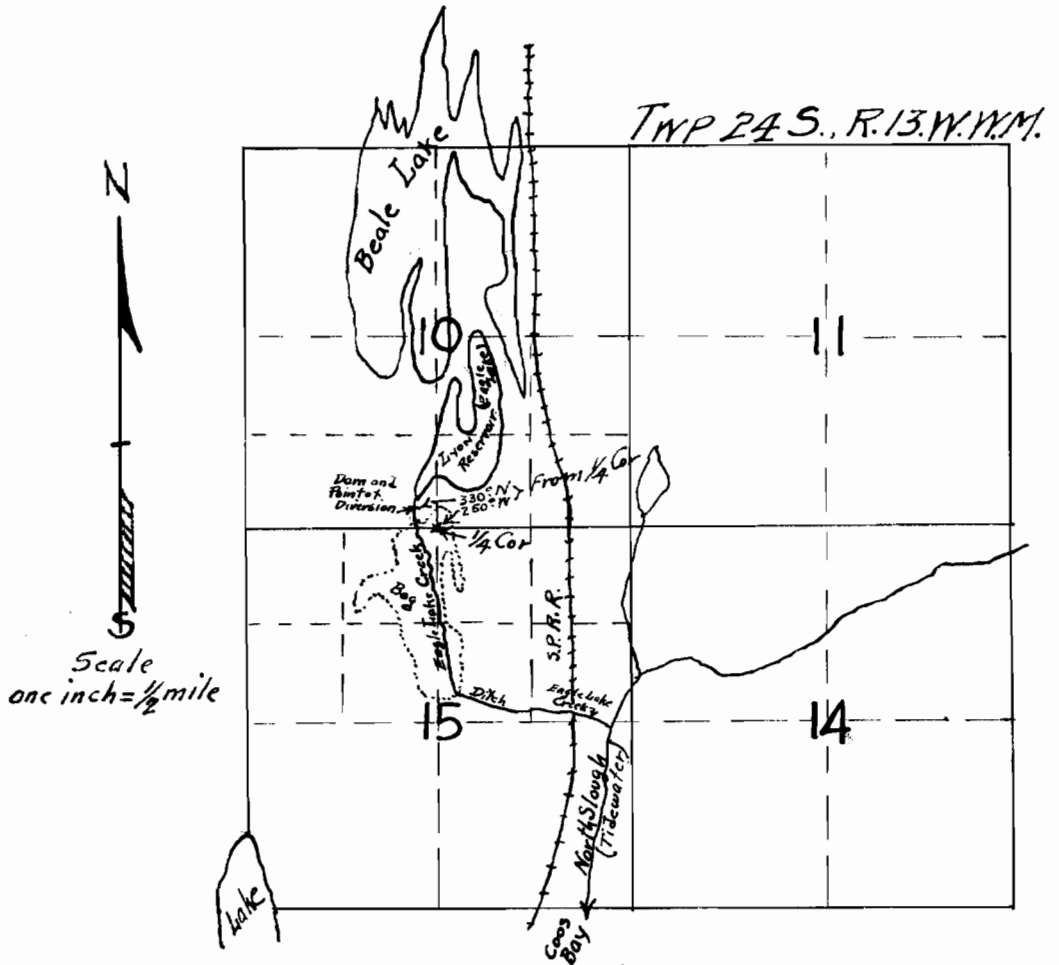

*D. L. Buckingham*

MAP  
To Accompany Application of Reuben Lyon  
for a permit to appropriate water  
Sec. 10 Twp 24 S. R. 13 W. N.W.M.

I, D. L. Buckingham of Marshfield, Oregon, do hereby certify that this map was made from notes taken during an actual survey made under my direction April 5 1931 and that it correctly represents the works described in the application, accompanying, together with the location of the streams in the immediate vicinity

*D. L. Buckingham*

Record No R-14504  
Plan No R-636

*See map  
and application*