


Sec. 33

Tp. 35 S

R. 22 E
W.M.

R-684

11458

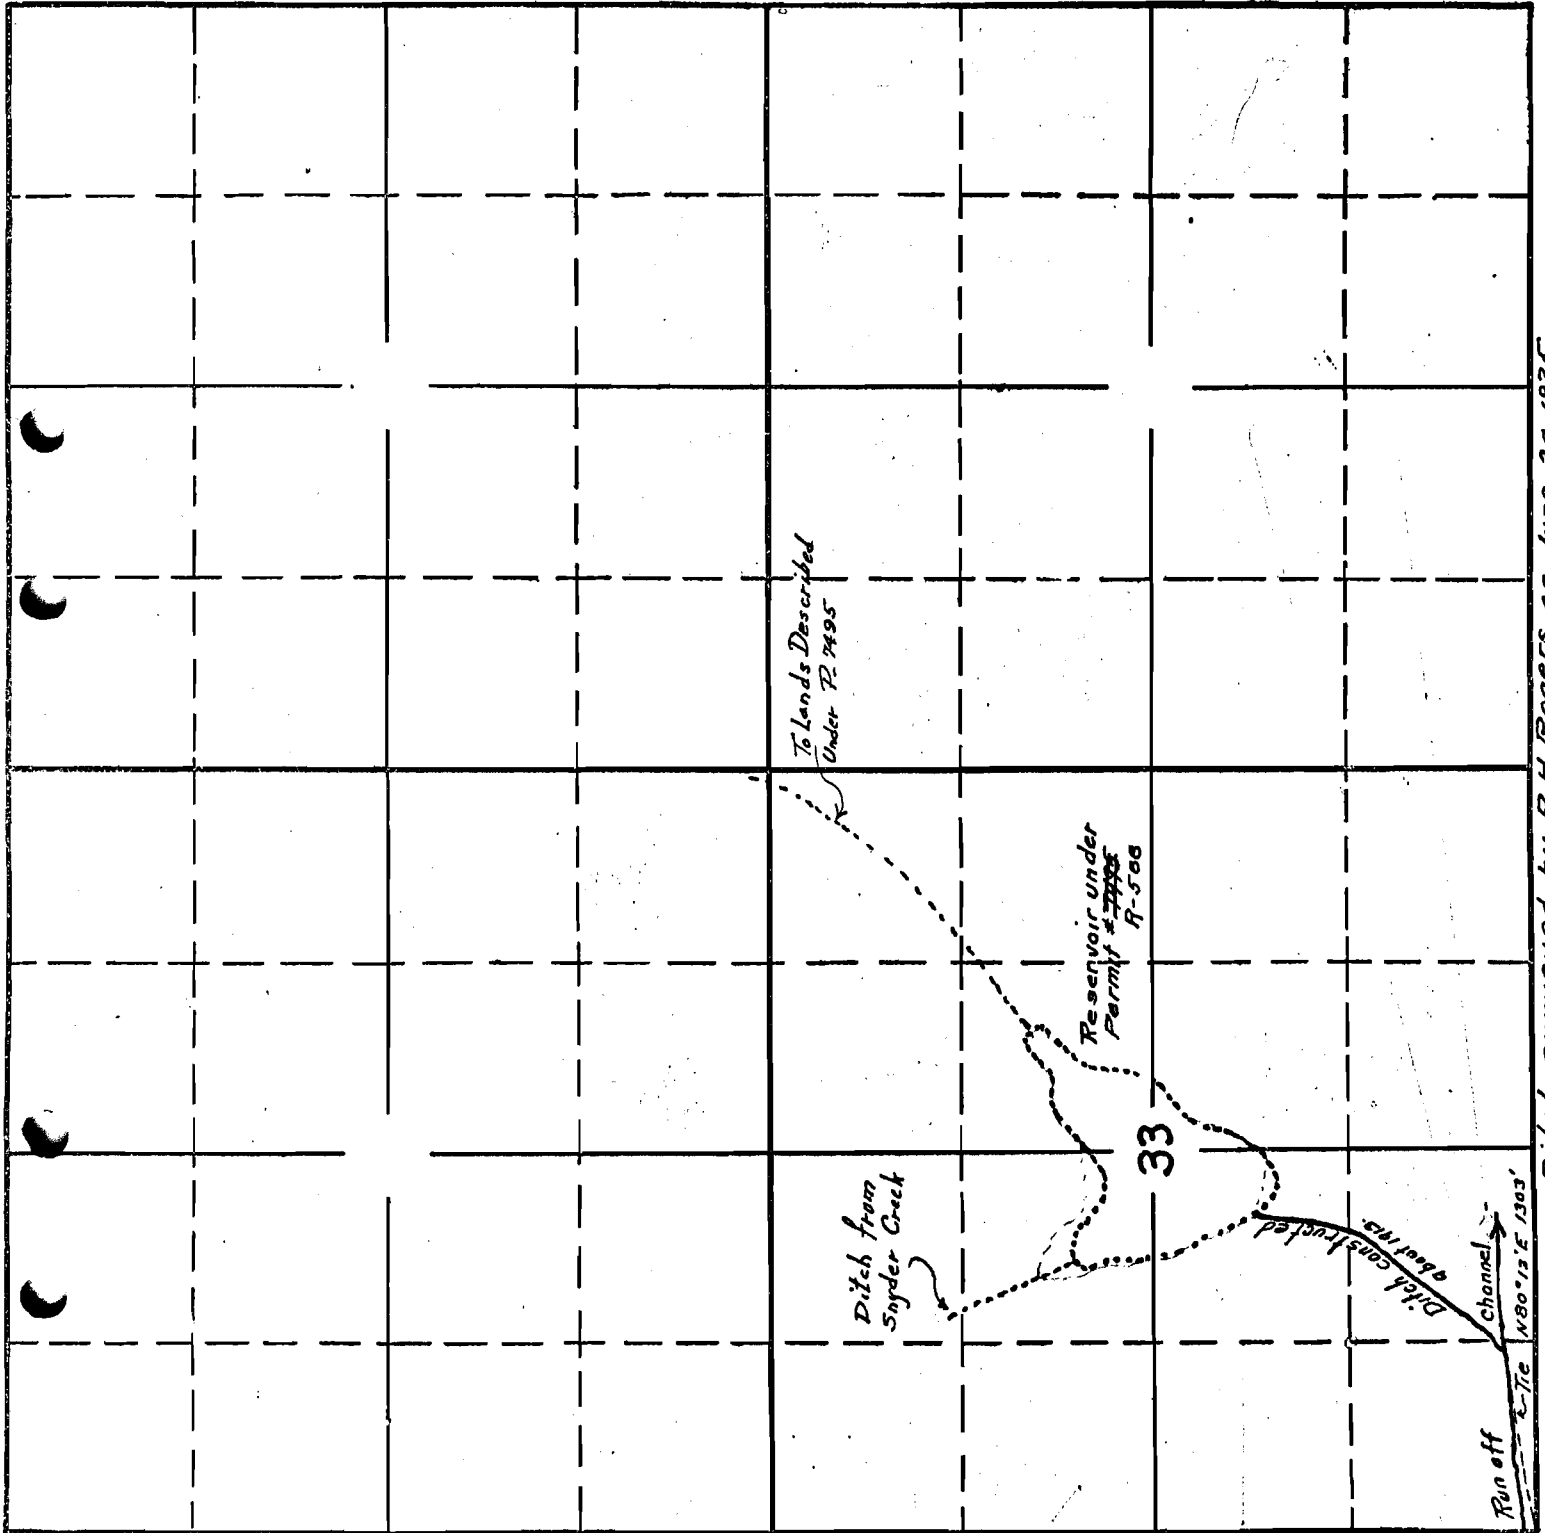

App. No. 15888

Per. No. R-684

35-22

✓