


SECTION

9666

TOWNSHIP 2 S, RANGE 13 E, W. M.

Foster Winslow

North

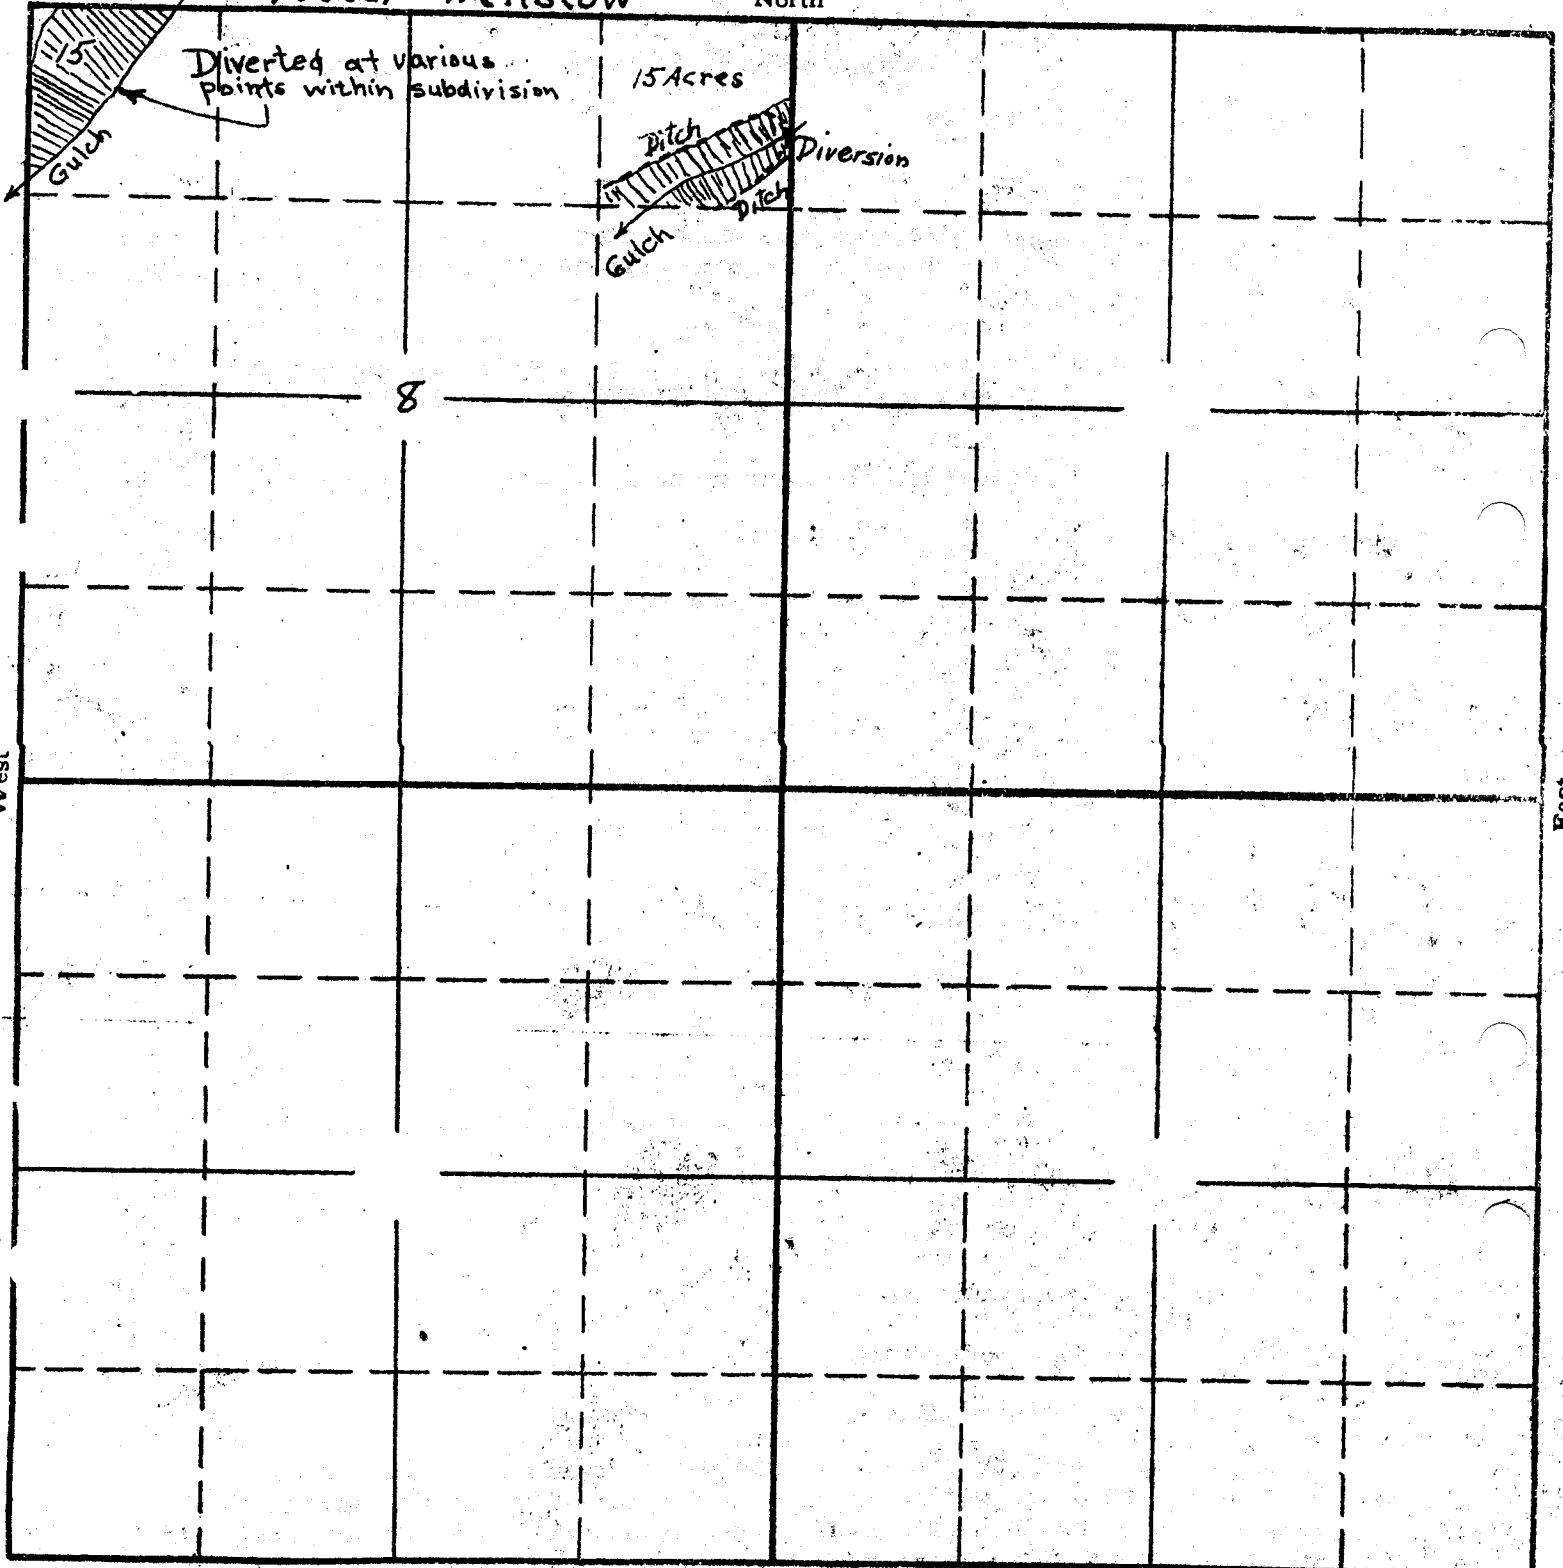

South

APPLICATION No. 13462

PERMIT No. 9666