

SECTION


11115
11485

TOWNSHIP 13S, RANGE 31E W. M.

North

West

East

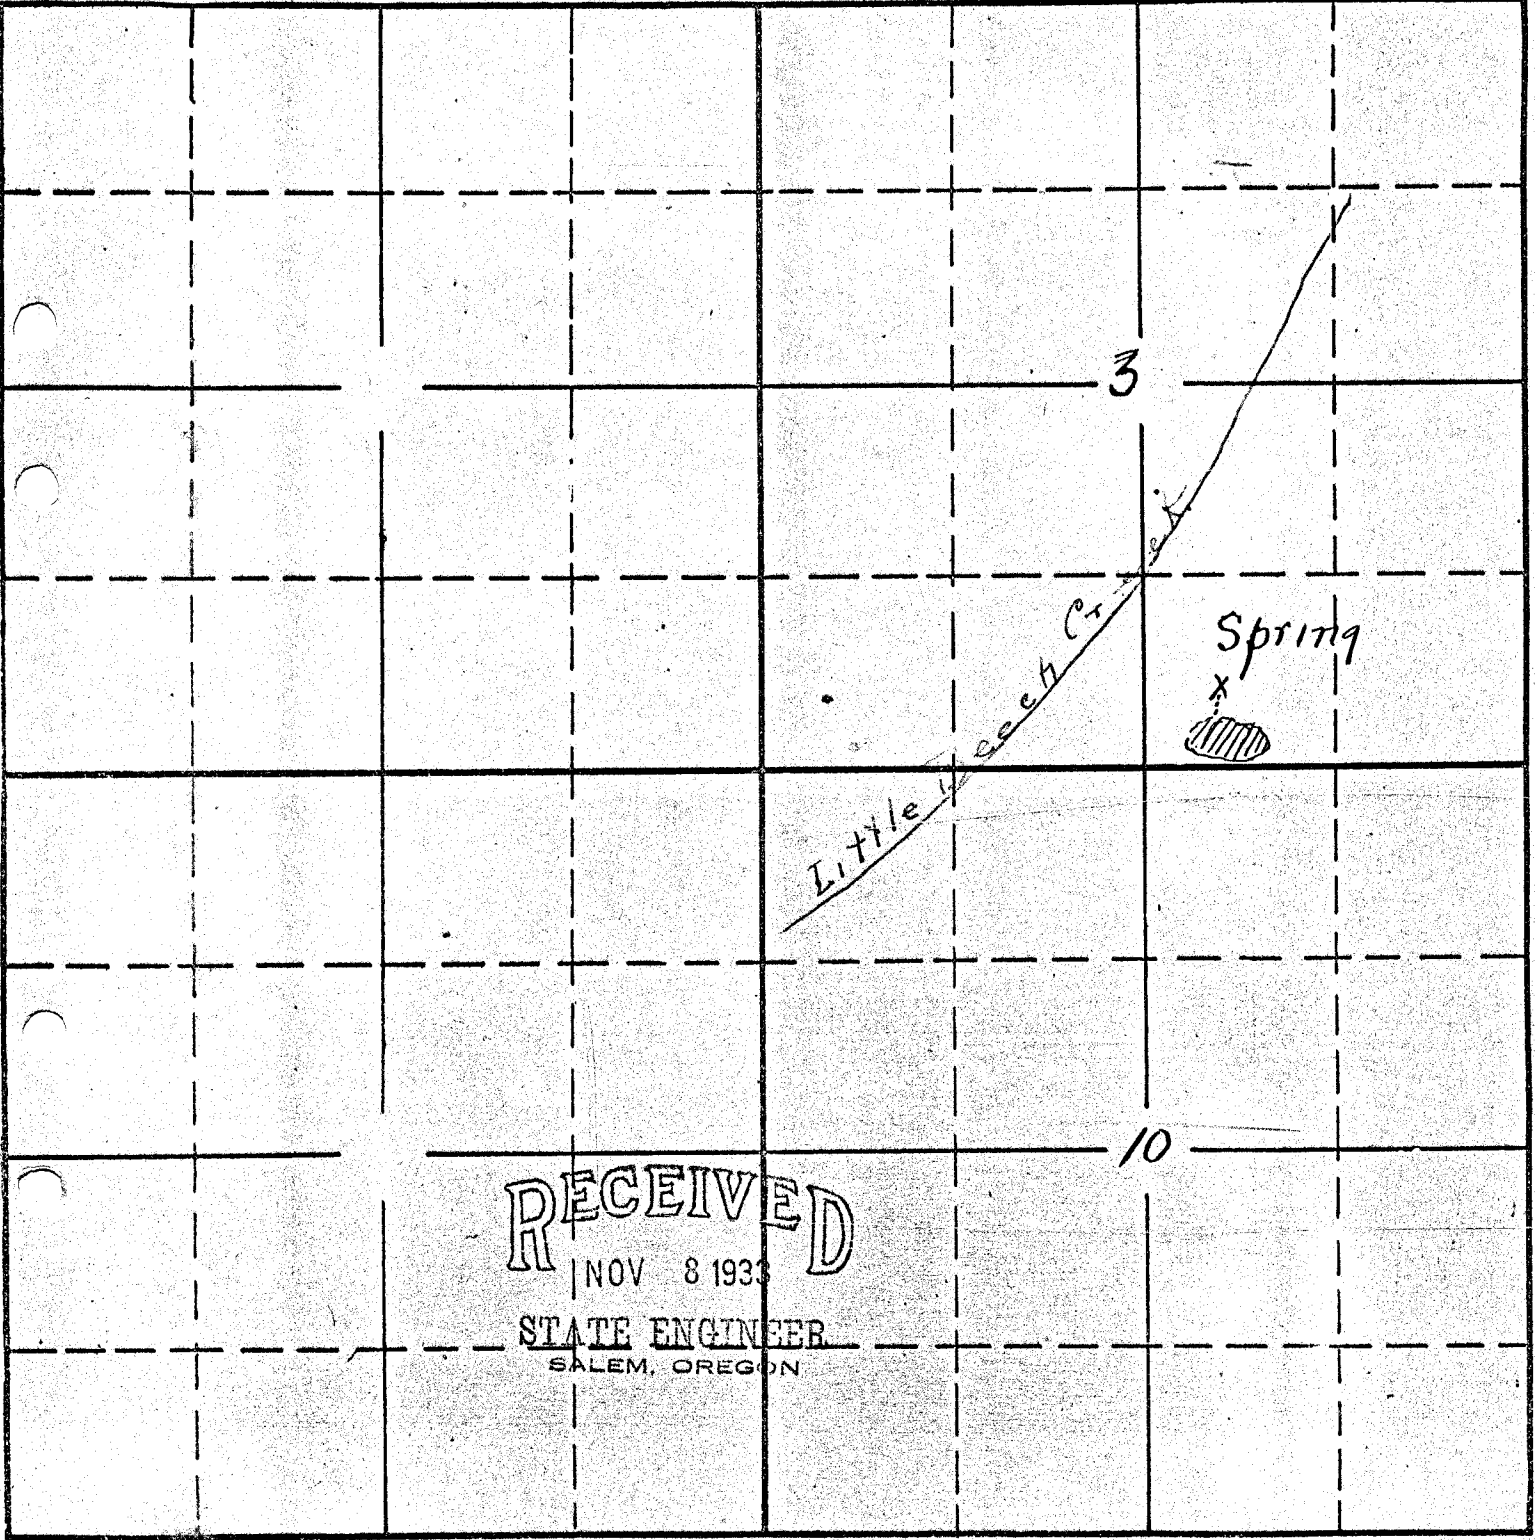

South

APPLICATION No. 15183
PERMIT No. 11115