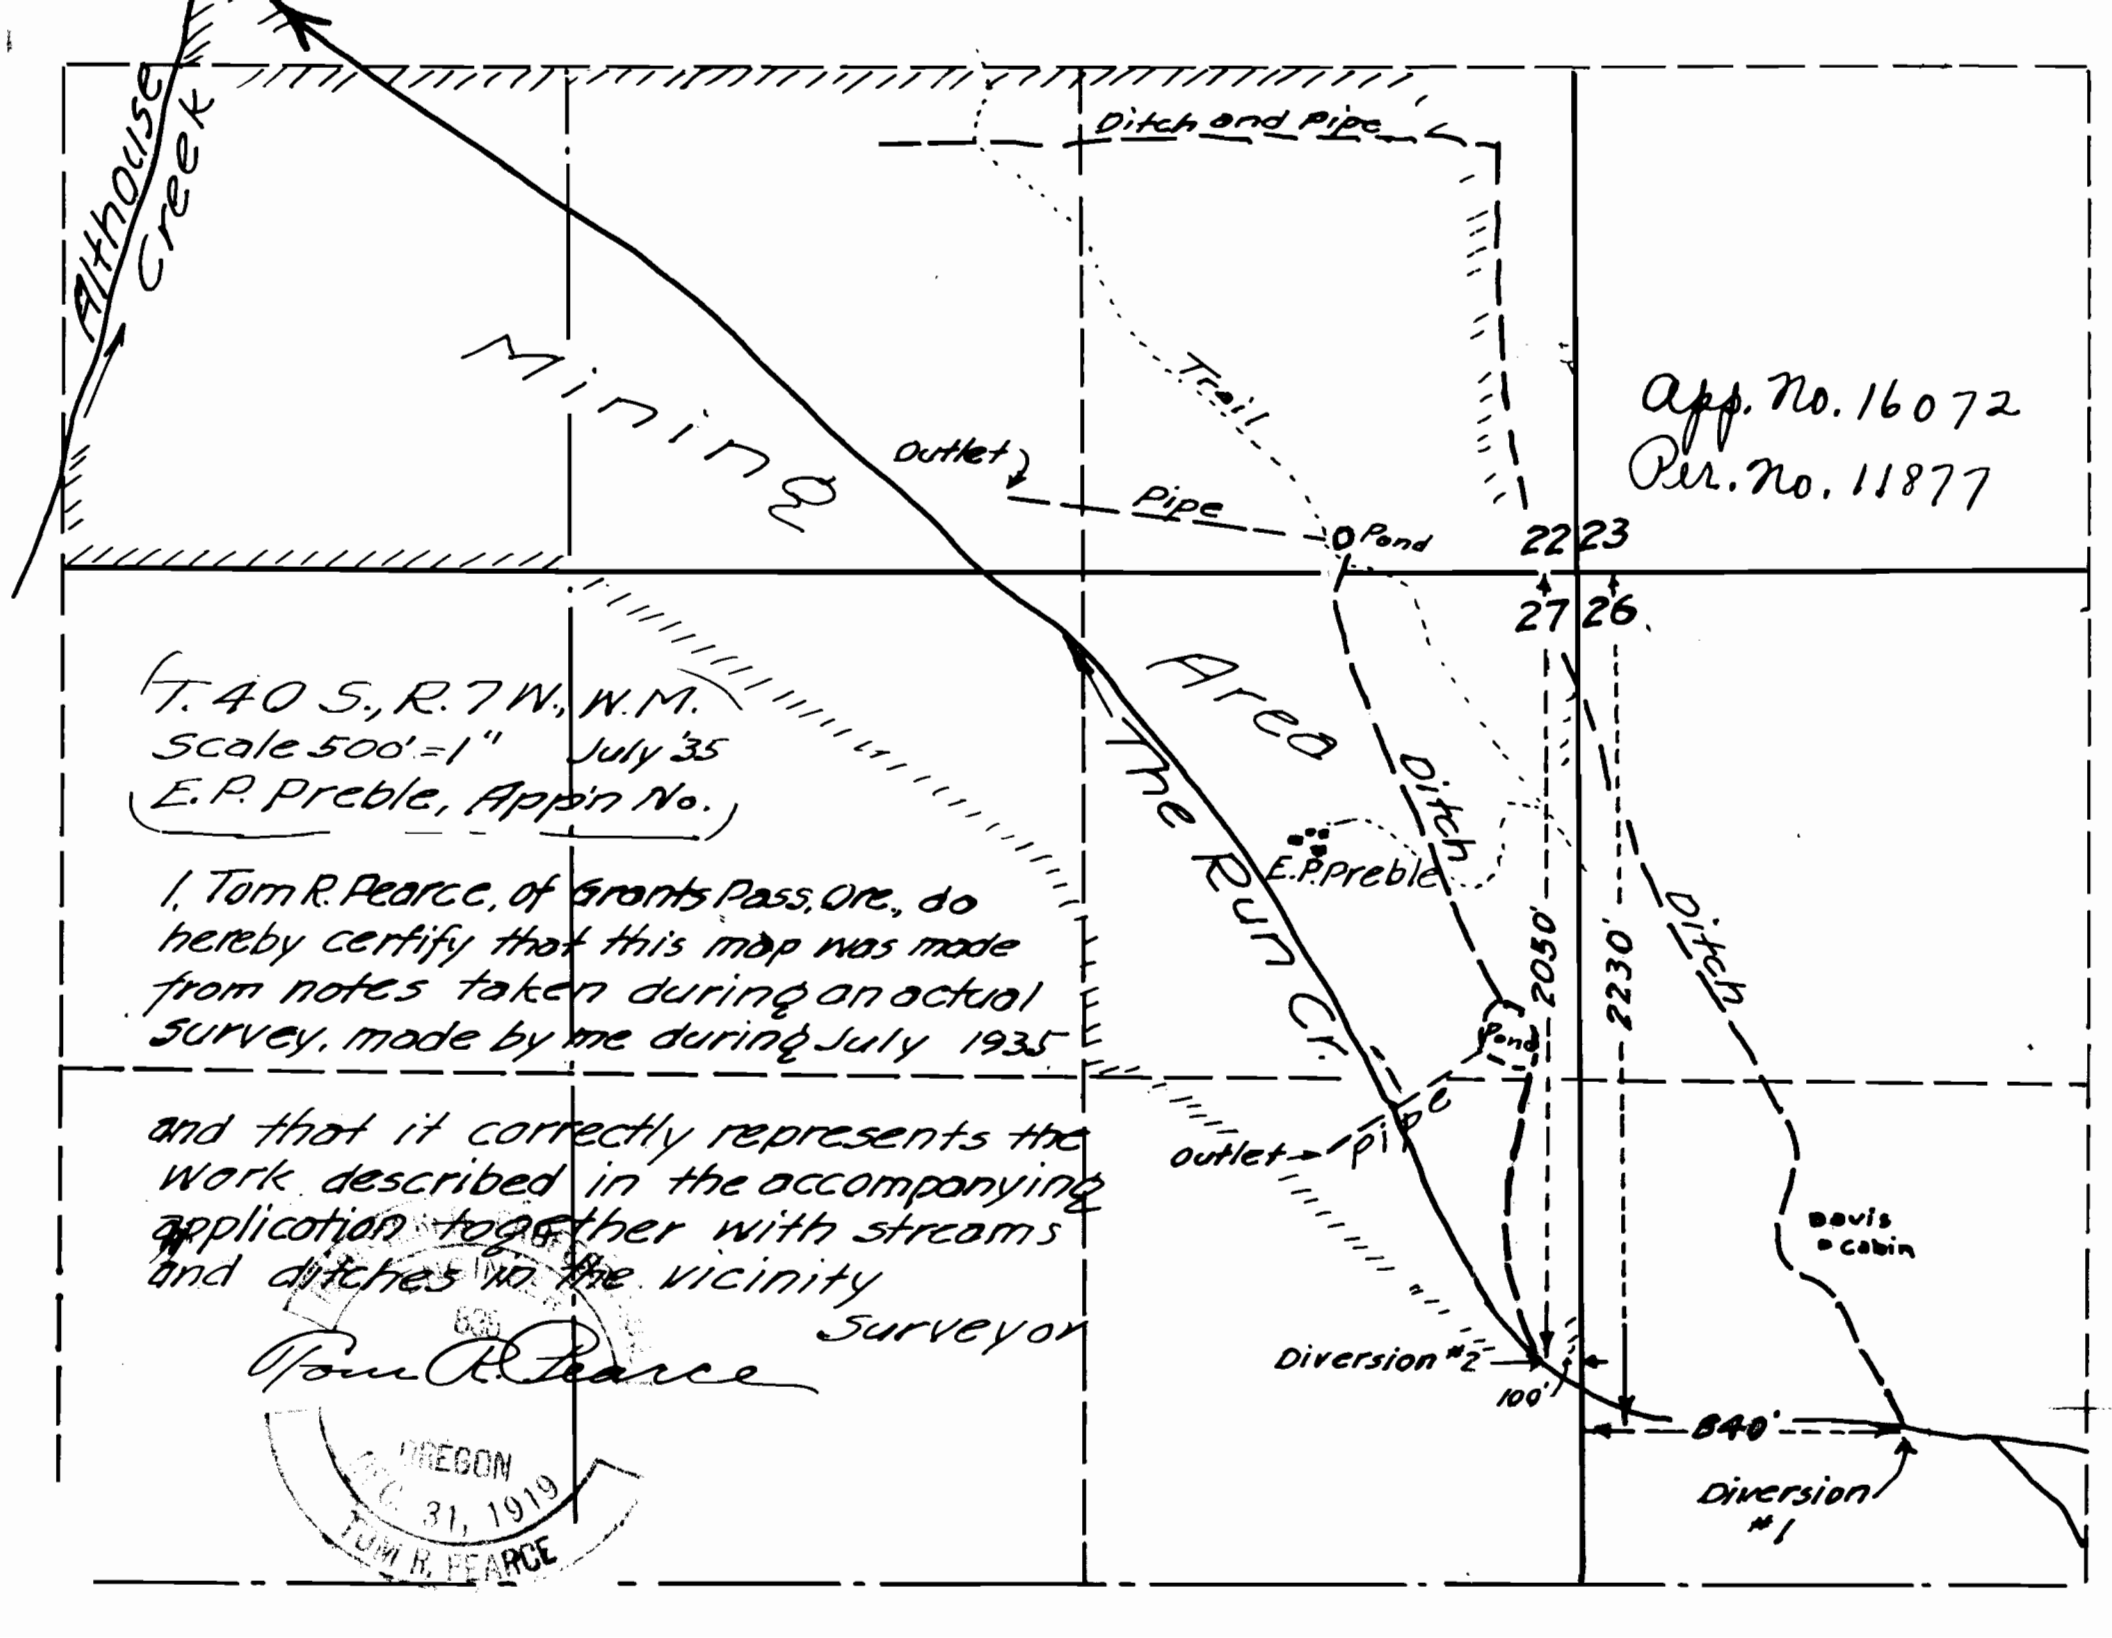

Althouse Creek
Mining Area
The Run Cr.
Ditch and Pipe
Trail
Outlet
Pipe
Pond
22
23
27
26
App. No. 16072
Per. No. 11877
T. 40 S., R. 7 W., W.M.
Scale 500'=1" July '35
E. P. Preble, Appn No.
I, Tom R. Pearce, of Grants Pass, Ore., do hereby certify that this map was made from notes taken during an actual survey, made by me during July 1935
and that it correctly represents the work described in the accompanying application together with streams and ditches in the vicinity
Surveyor
Tom R. Pearce
OREGON
DEC 31, 1919
TOM R. PEARCE
E. P. Preble
ditch
2050'
2230'
ditch
Pond
Outlet
Pipe
Davis Cabin
Diversion #2
100'
640'
Diversion #1