

Should be 12W instead of  
11W - see correspondence in  
folder B


I. Z. M. Derrick, of Toledo, do hereby  
certify that this map was made  
from notes taken during an actual  
survey made by me on Oct 17 1925  
and that it correctly represent  
the works described in the  
accompanying application together  
with the location of streams and  
other ditches in the immediate vicinity

OREGON 70710

*I. Z. M. Derrick*  
REGISTERED PROFESSIONAL ENGINEER

DEC 31 1919

T. 14 S. R. 11 W. W. 4

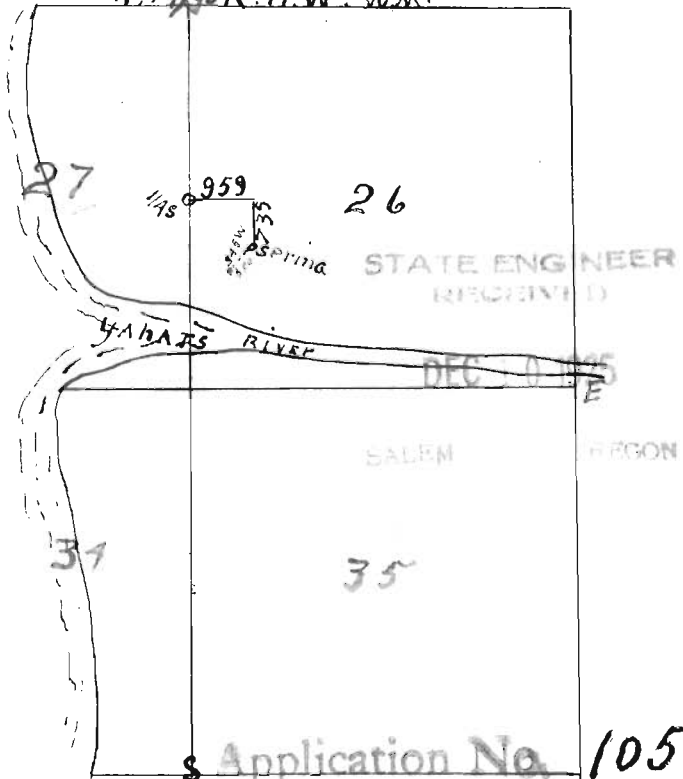

Application No. 10517

Permit No. 7072

10517