


2157

OFFICE OF STATE ENGINEER
RECEIVED
AUG 18 1916

Application No. 5124
Permit No. 3074

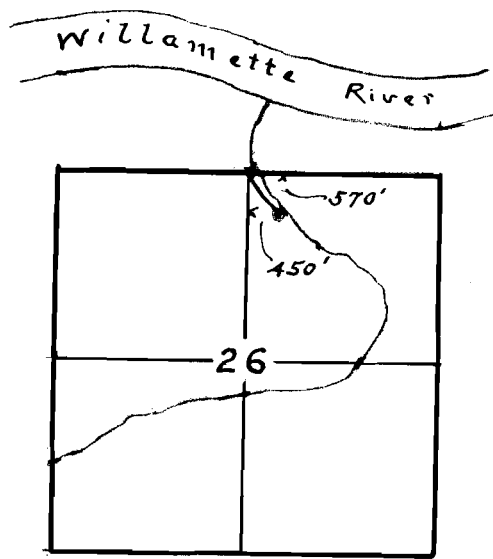

*Application of Mrs. F.W. Prahl
to appropriate water
from Spring in
Sec. 26, T. 3 S., R. 1 W., W.M.
for Domestic Purposes.
Aug. 1916.*

2157