



T. 7 & 8 S. R. 4 W. W. M.

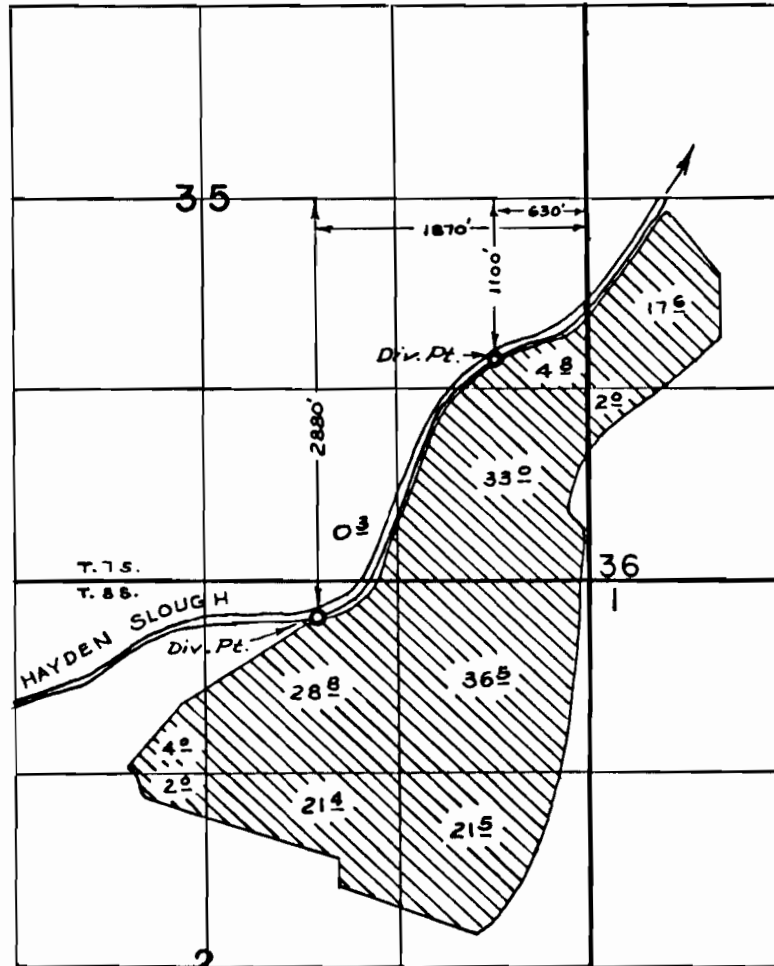

Scale 1" = 1320'

CORRECTION MAP
FOR
APPLIC. No. 11918 PERMIT No. 8298
GREEN VILLA FARMS

THE PREPARATION OF THIS MAP IS FOR THE
PURPOSE OF IDENTIFYING THE LOCATION
OF THE WATER RIGHT ONLY AND HAS NO
INTENT TO PROVIDE DIMENSIONS OR LOCATION
OF PROPERTY OWNERSHIP LINES.

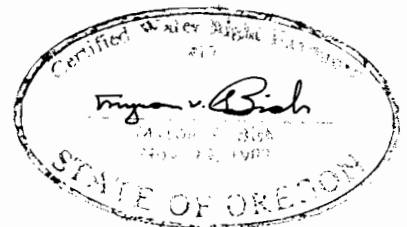

11718

34

35

36

T. 7 S. R. 4 W.
T. 8 S. R. 4 W.

3

2

10

10

11

12 chs.

20

Pump No. 1

5

5

30

20 chs.

Pump No. 2

25

39

3

3

2

Hayden Slough

Hayden Lake

15

Pump No. 3

Dam

38

10

South Lake

Willamette River

PLAT
OF
E.C. HORST CO'S LAND
IN
POLK COUNTY
OREGON
SHOWING IRRIGATION SYSTEM
KNOWN AS
NORTH SLOUGH SYSTEM

Edw. J. Himes
Engr.

Scale 1 IN. = 20 Chs.

8298

