


S, R35E,

SEC.

9.

N.

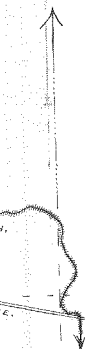

PIPE LINE NOW IN USE.

STANDARD PIPE & TANK
LOCATED ON LOT NO. 7
BLK. 4, GREENHORN, ORF.
FIRE & DOMESTIC SERVICE
PIPES LAID & SYSTEM IN

App 1062

Re 504