


SECTION

3

TOWNSHIP 38S RANGE 9 W W. M.



North

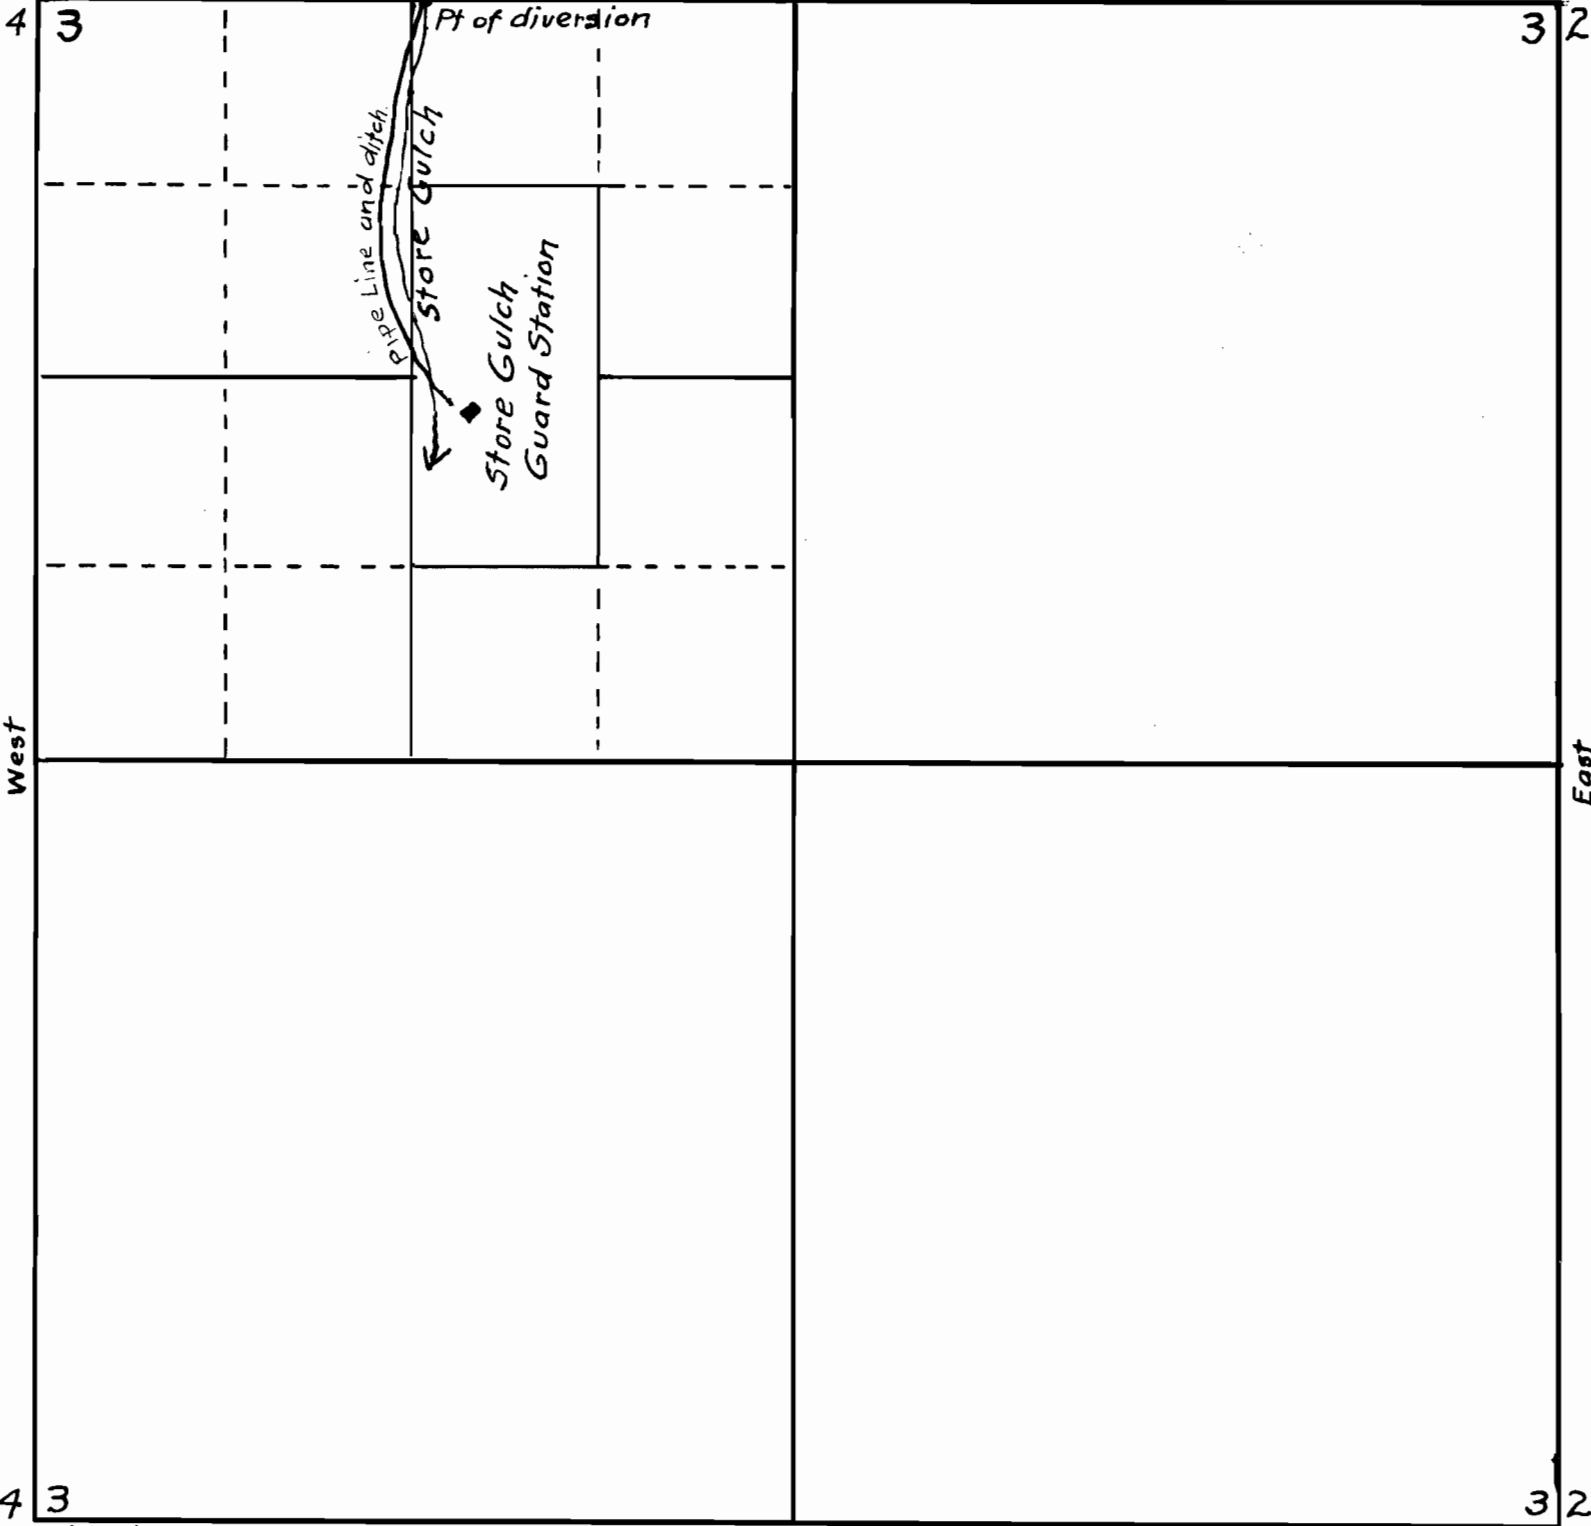

West

East

South

A.G.U. Aug. 17, 1932.

APPLICATION No. 14697
PERMIT No. 10670