

SECTION


Per 11626
11550

TOWNSHIP 8 S, RANGE 35 1/2 E, W. M.

North

East

South

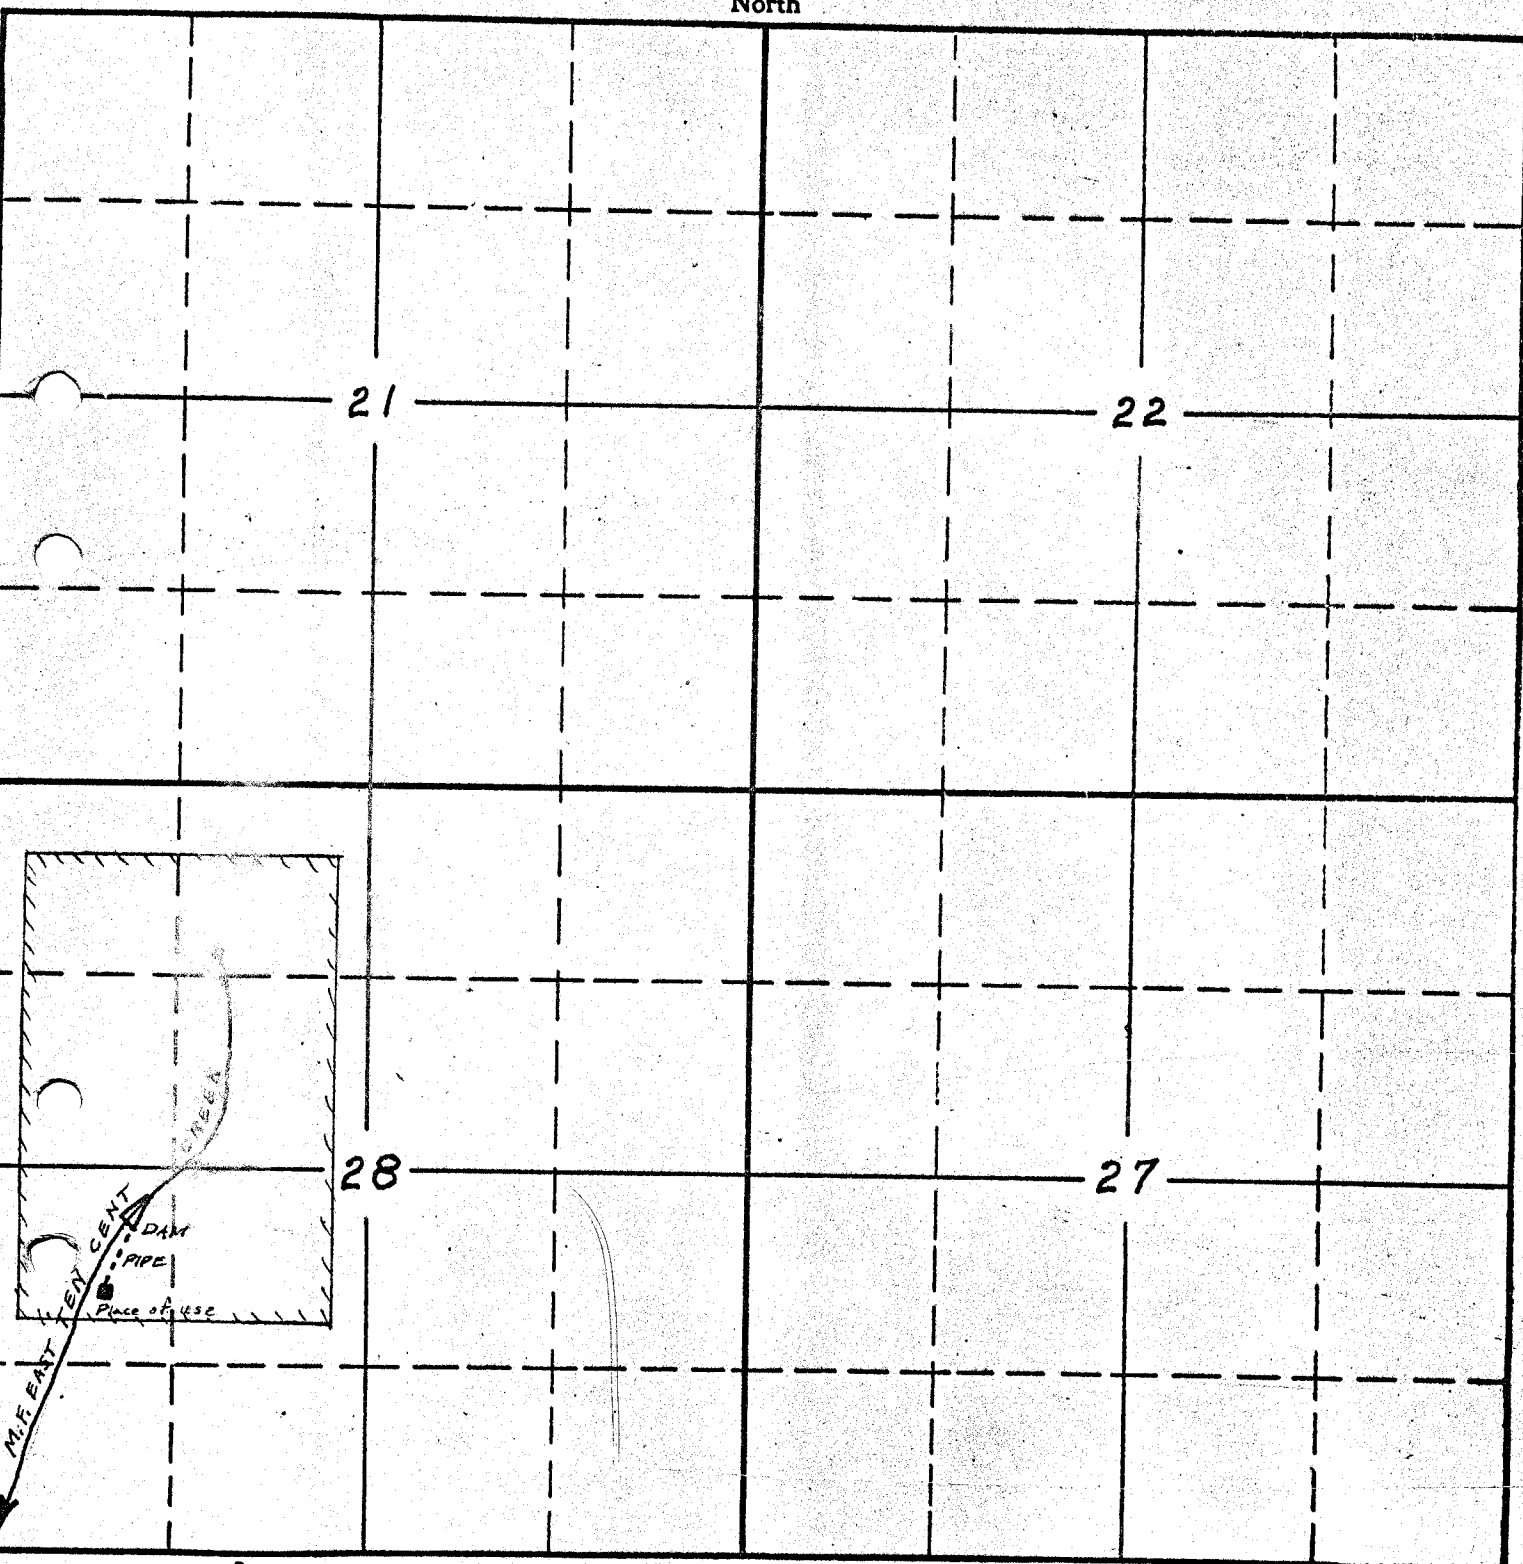

Copied from applicant's
sketch - 4/20/35.

APPLICATION No. 15291
PERMIT No. 11626