


SECTION

PNE

11991
11573

TOWNSHIP 39S, RANGE 19 E, W. M.

North

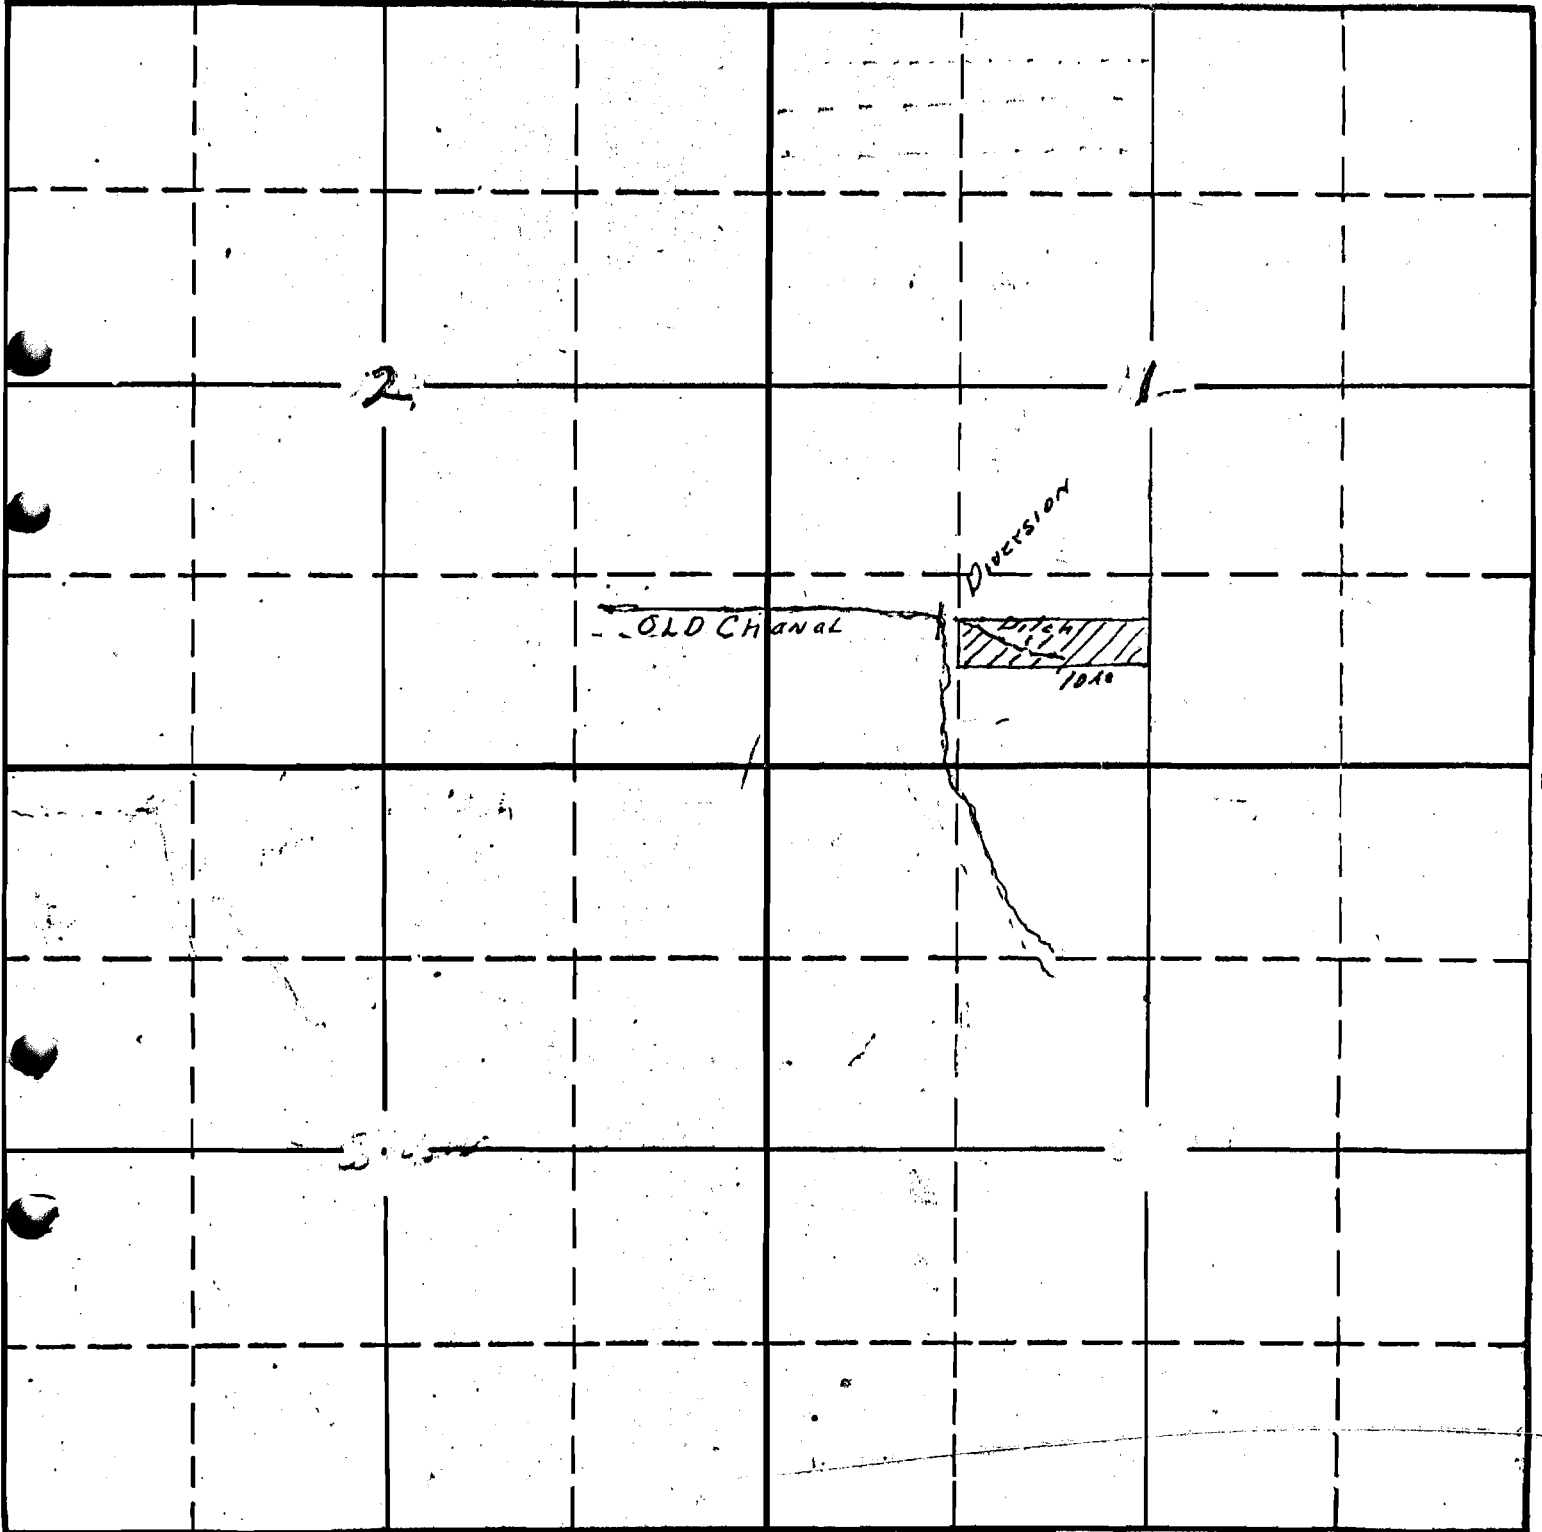

South

RECEIVED
DEC 9 1935
STATE ENGINEER

APPLICATION No. 16185
PERMIT No. 11991

39-19 ✓