


SECTION

11082
C# 1138L
11578

TOWNSHIP 40 S, RANGE 19 E, W. M.

North

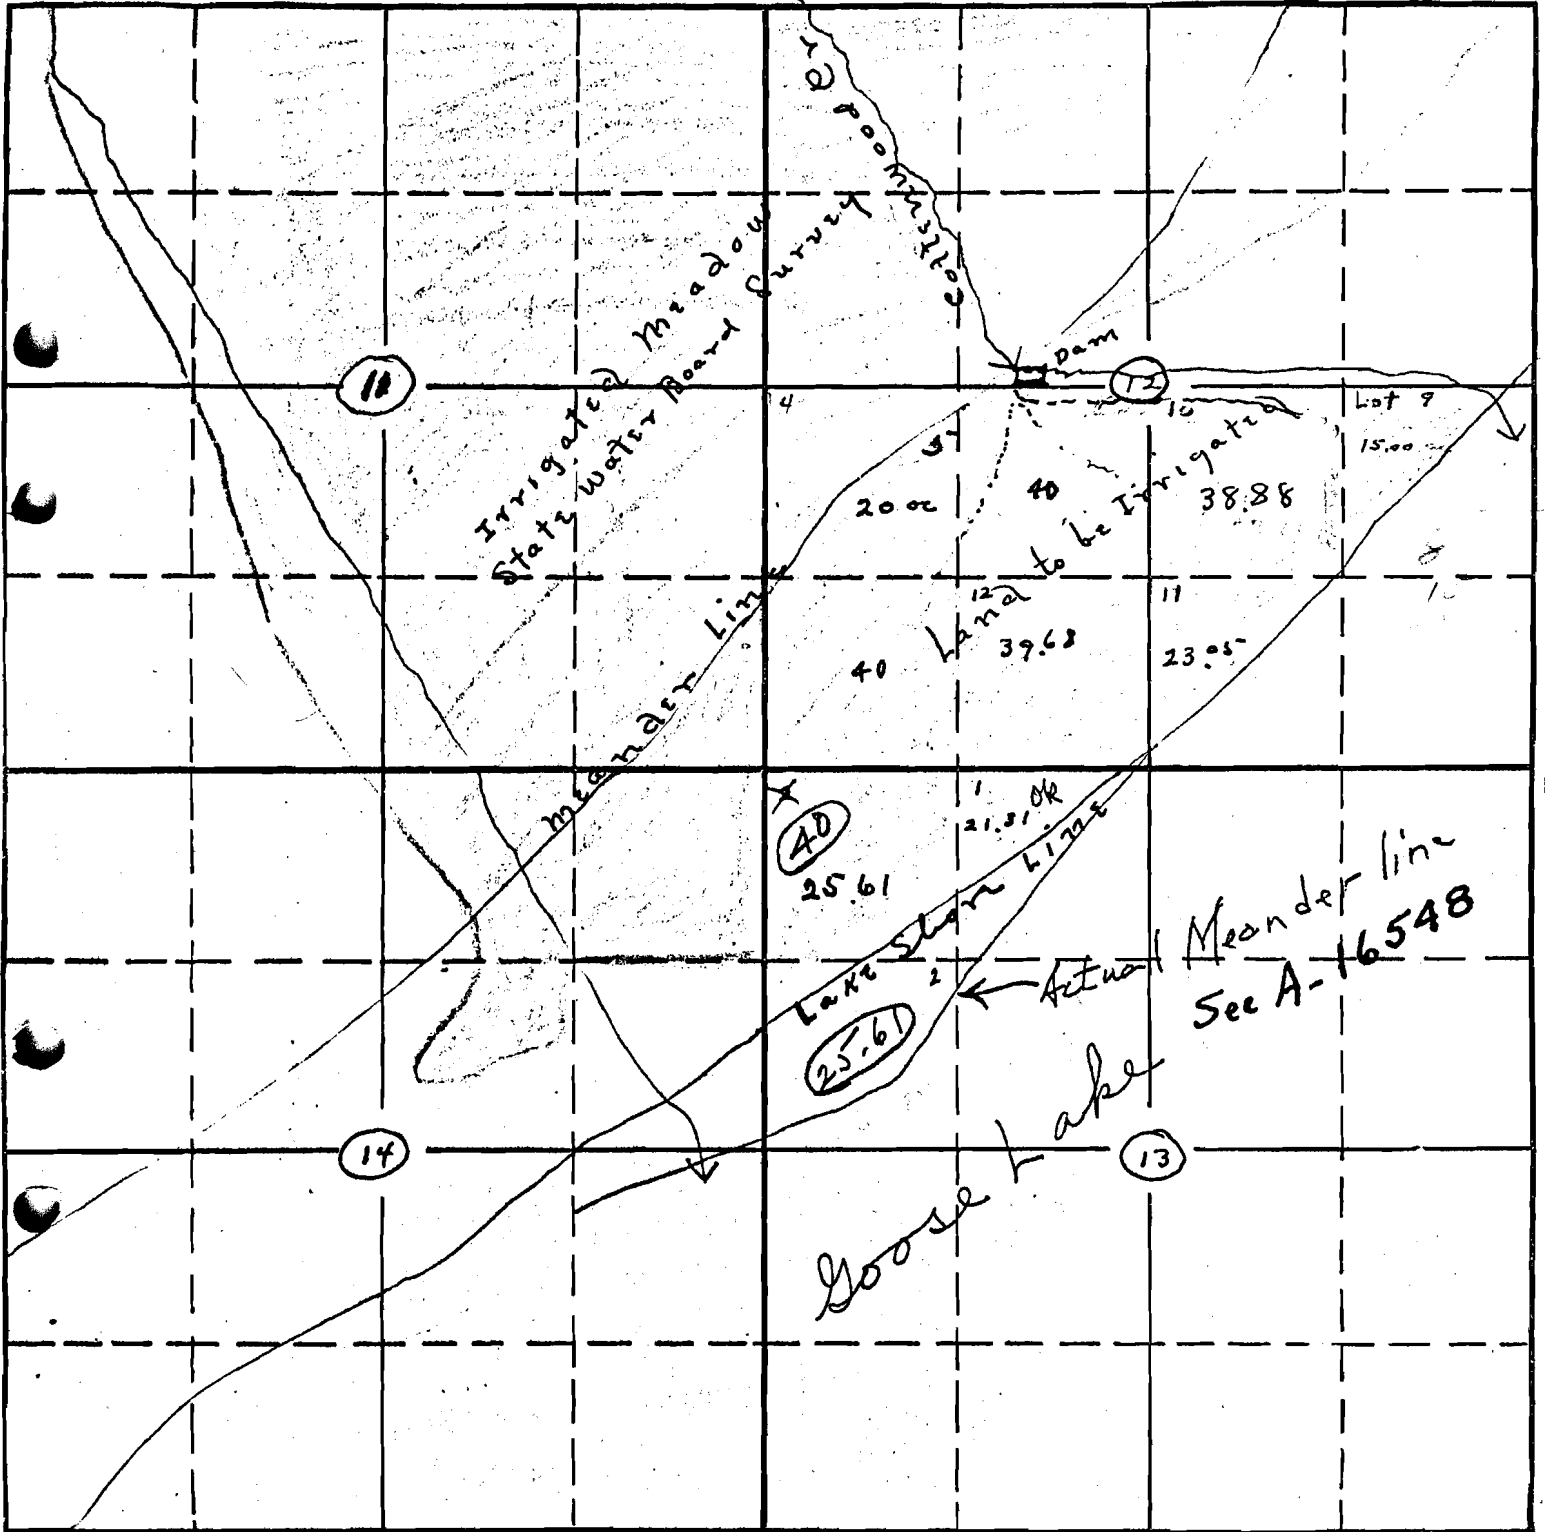

South

RECEIVED
OCT 18 1933

STATE ENGINEER
SALEM, OREGON

APPLICATION No. 15161
PERMIT No. 11082

40-19 ✓