


U-84  
11582

TOWNSHIP 38 S, RANGE 9 E, W. M.

Klamath Falls

North

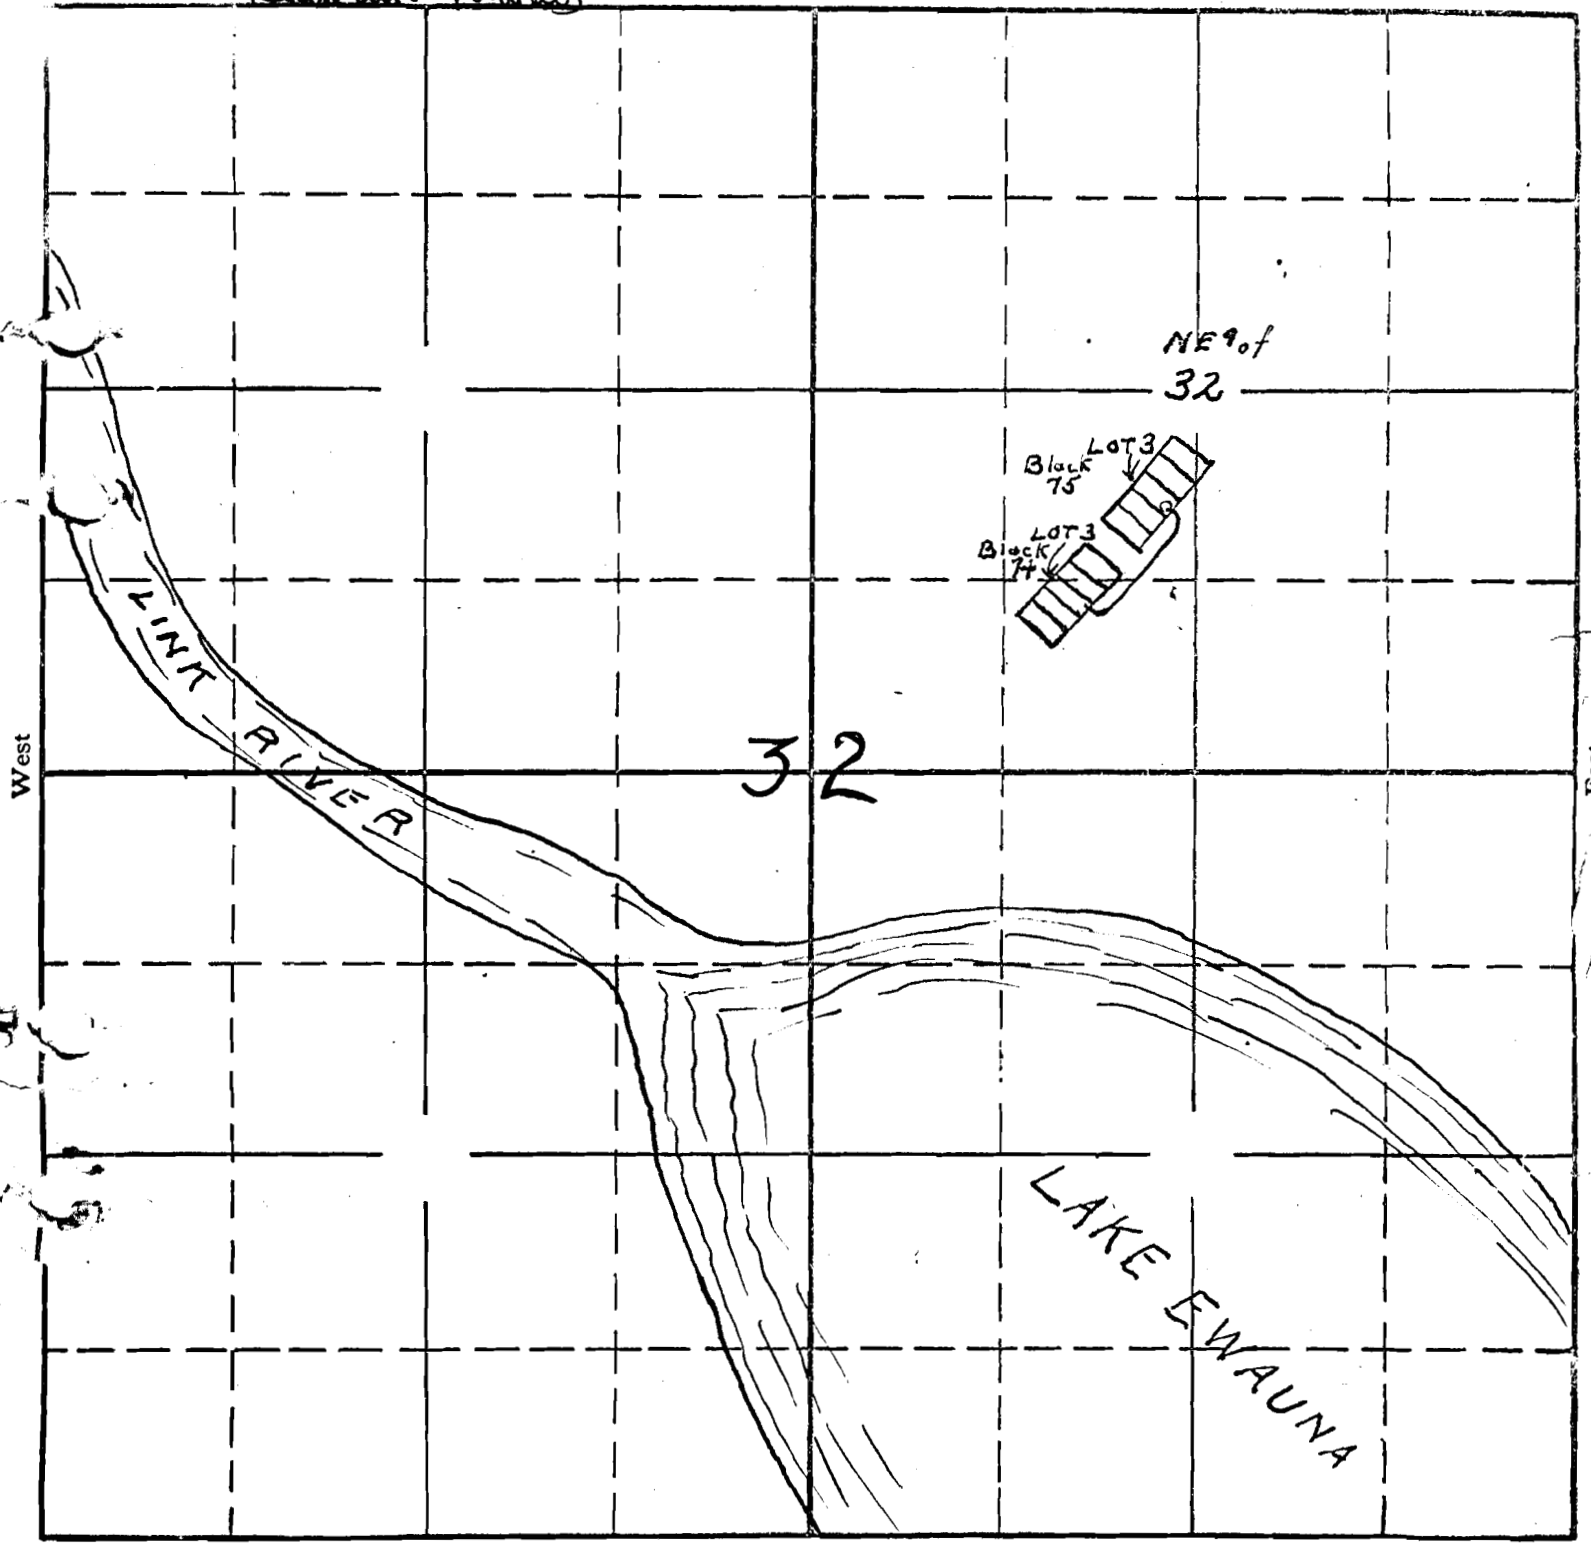

South

APPLICATION No. U-89  
PERMIT No. U-84