


8976

1.072 11587

This sketch to accompany final proof - Permit No. 8976

Irrigated Land 
Ditches 

T. 40 S. R. 12 E.

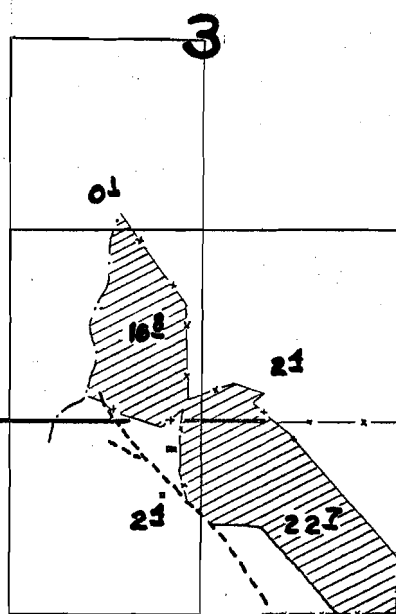

John M^s Fall

10

Note:-

This supersedes that part of
original map showing irrigated
areas.

App 12625


Per 8976

Scale: 4 in. = 1 mile

Surveyed Sept 3, 1936

East River mace.

8976
2072

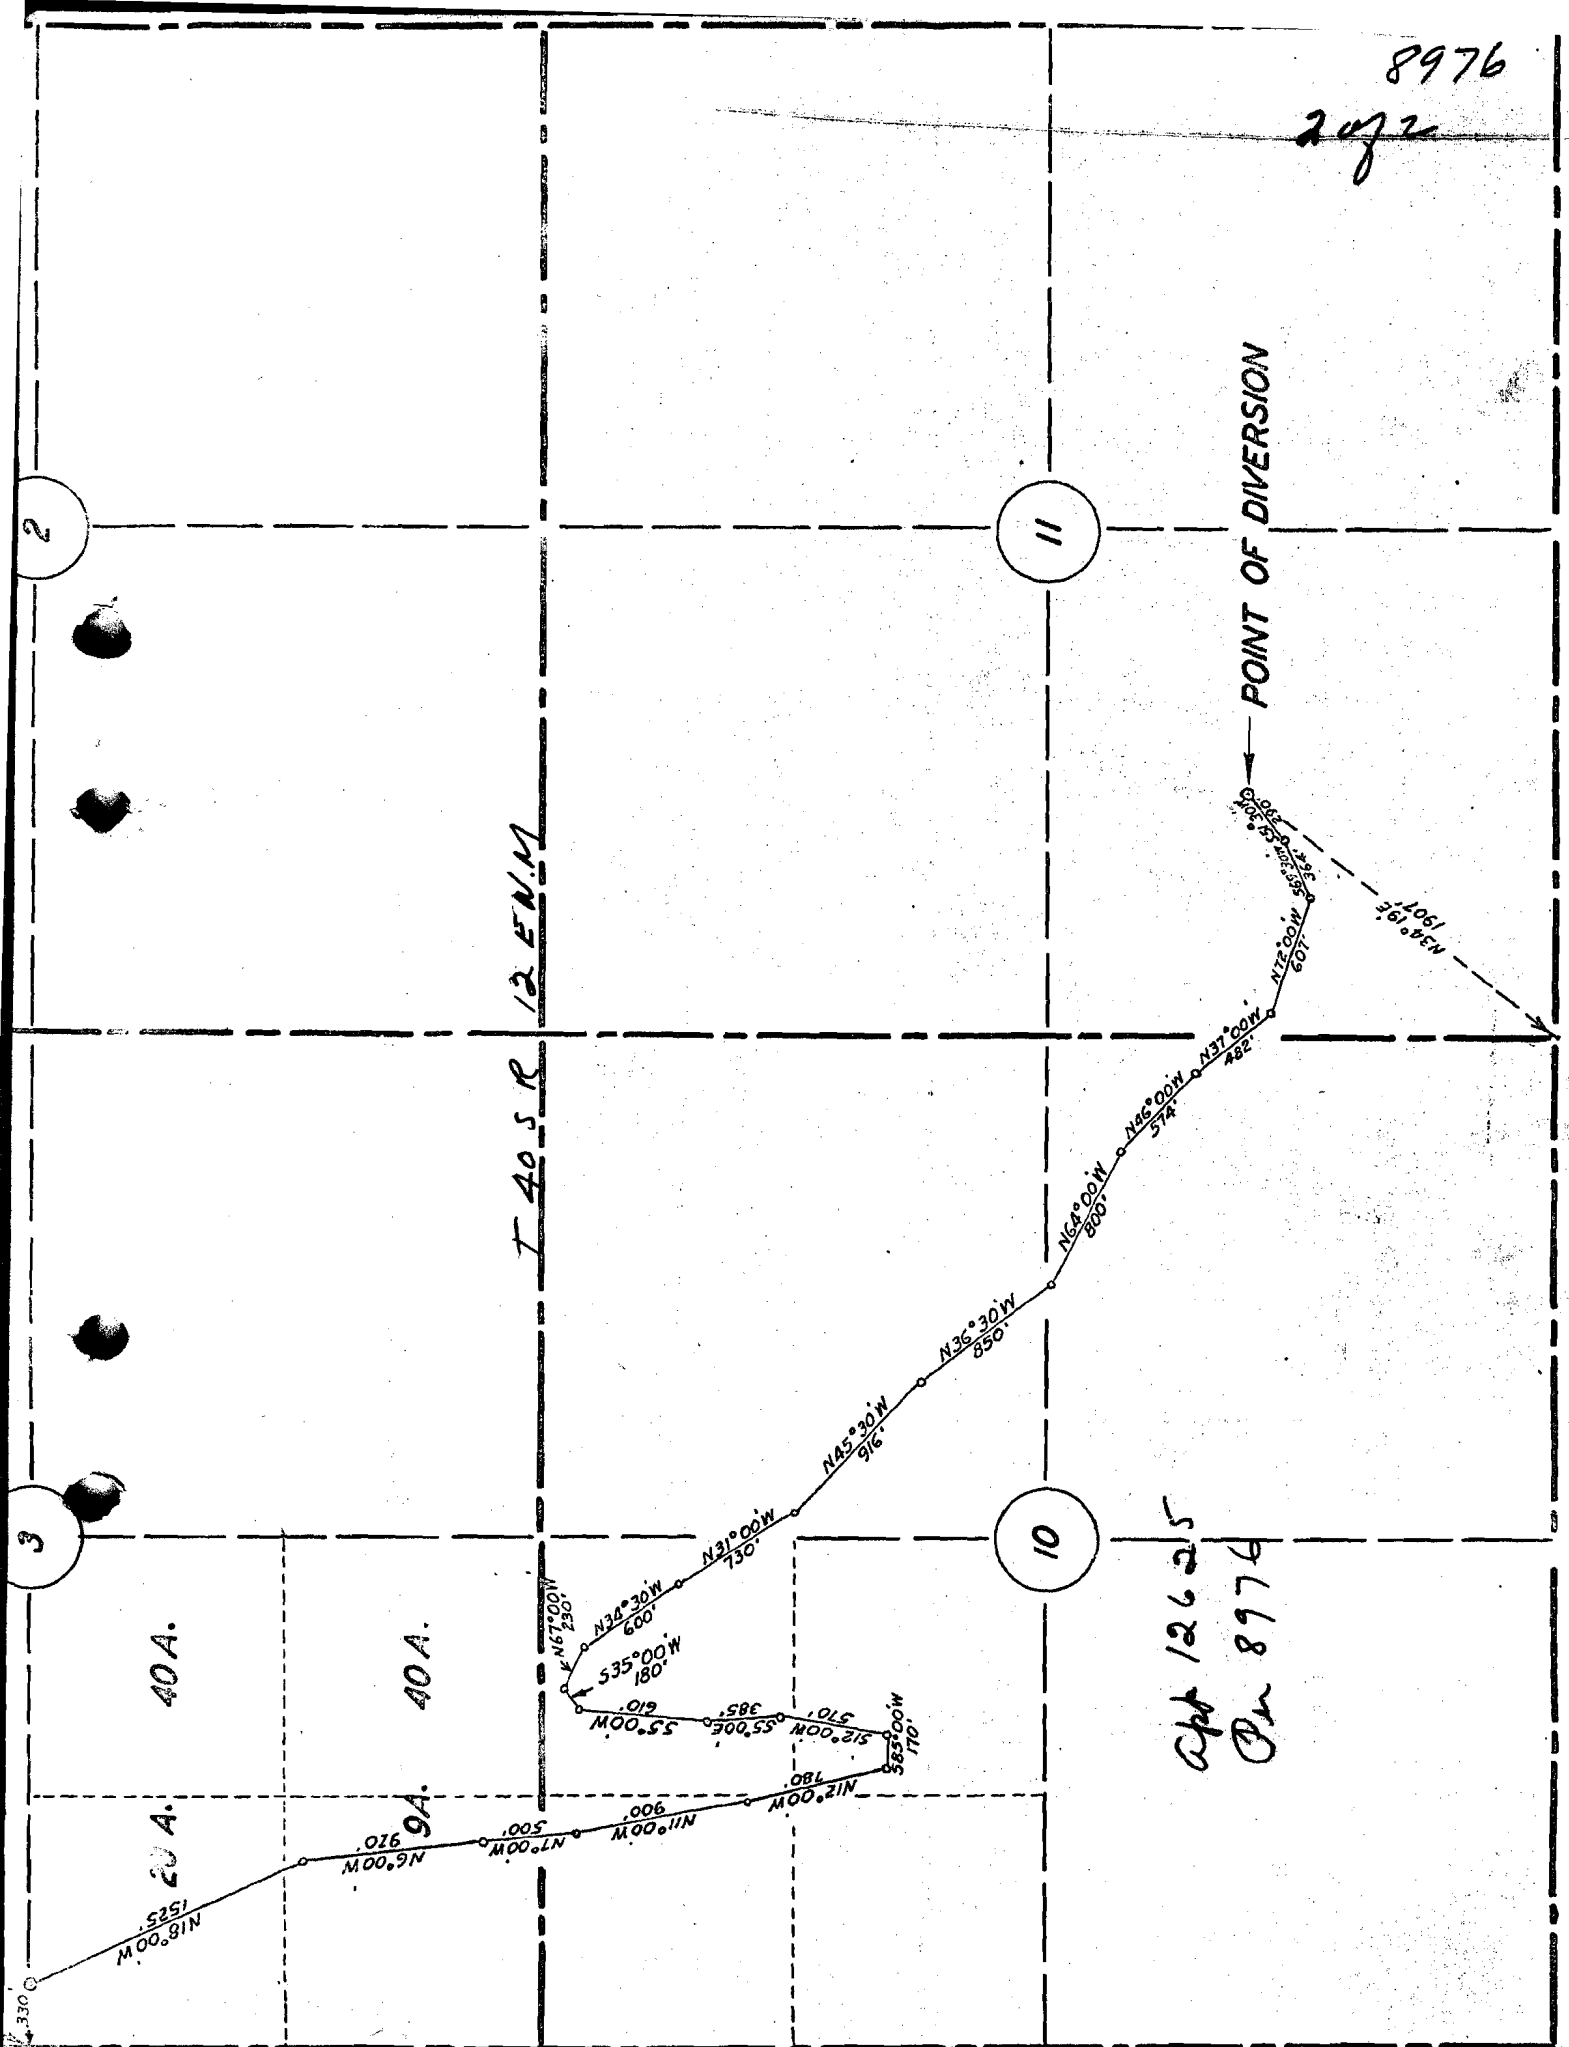

Township 40 S Range 12 E N 1 M

Apr 12 62 5
Pr 8976