

9837


SURVEY IN \_\_\_\_\_ SECT. \_\_\_\_\_ TWP. \_\_\_\_\_ RANGE \_\_\_\_\_ EAST W. M.

DATE \_\_\_\_\_

*Handwritten notes:*  
FOR  
20  
10

Application No. 13684  
Permit No. 9837

*Handwritten notes:*  
10  
10

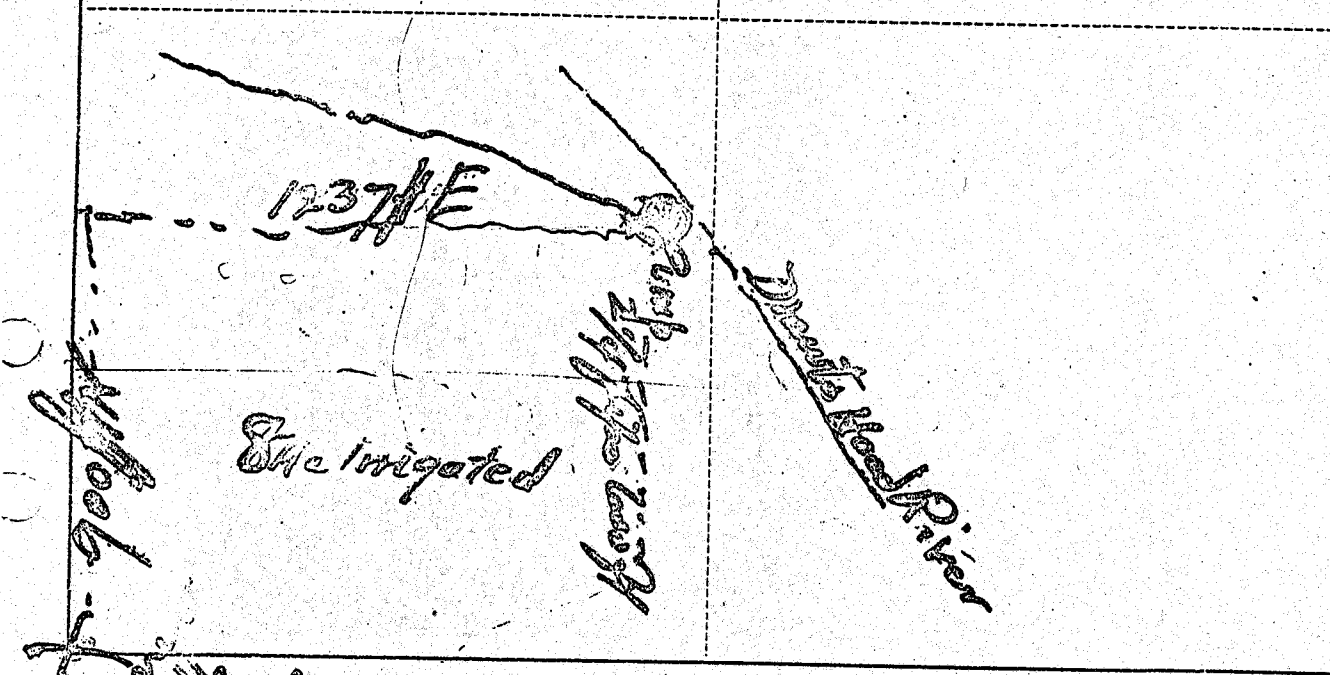

*Handwritten notes:*  
SW corner  
Sept 16  
1910

I do hereby certify that this sketch was made from notes taken during an actual survey made by me on \_\_\_\_\_ 192\_\_\_\_, and that it correctly represents field work of said survey.

County Surveyor  
Hood River County, Oregon

Helpers \_\_\_\_\_