



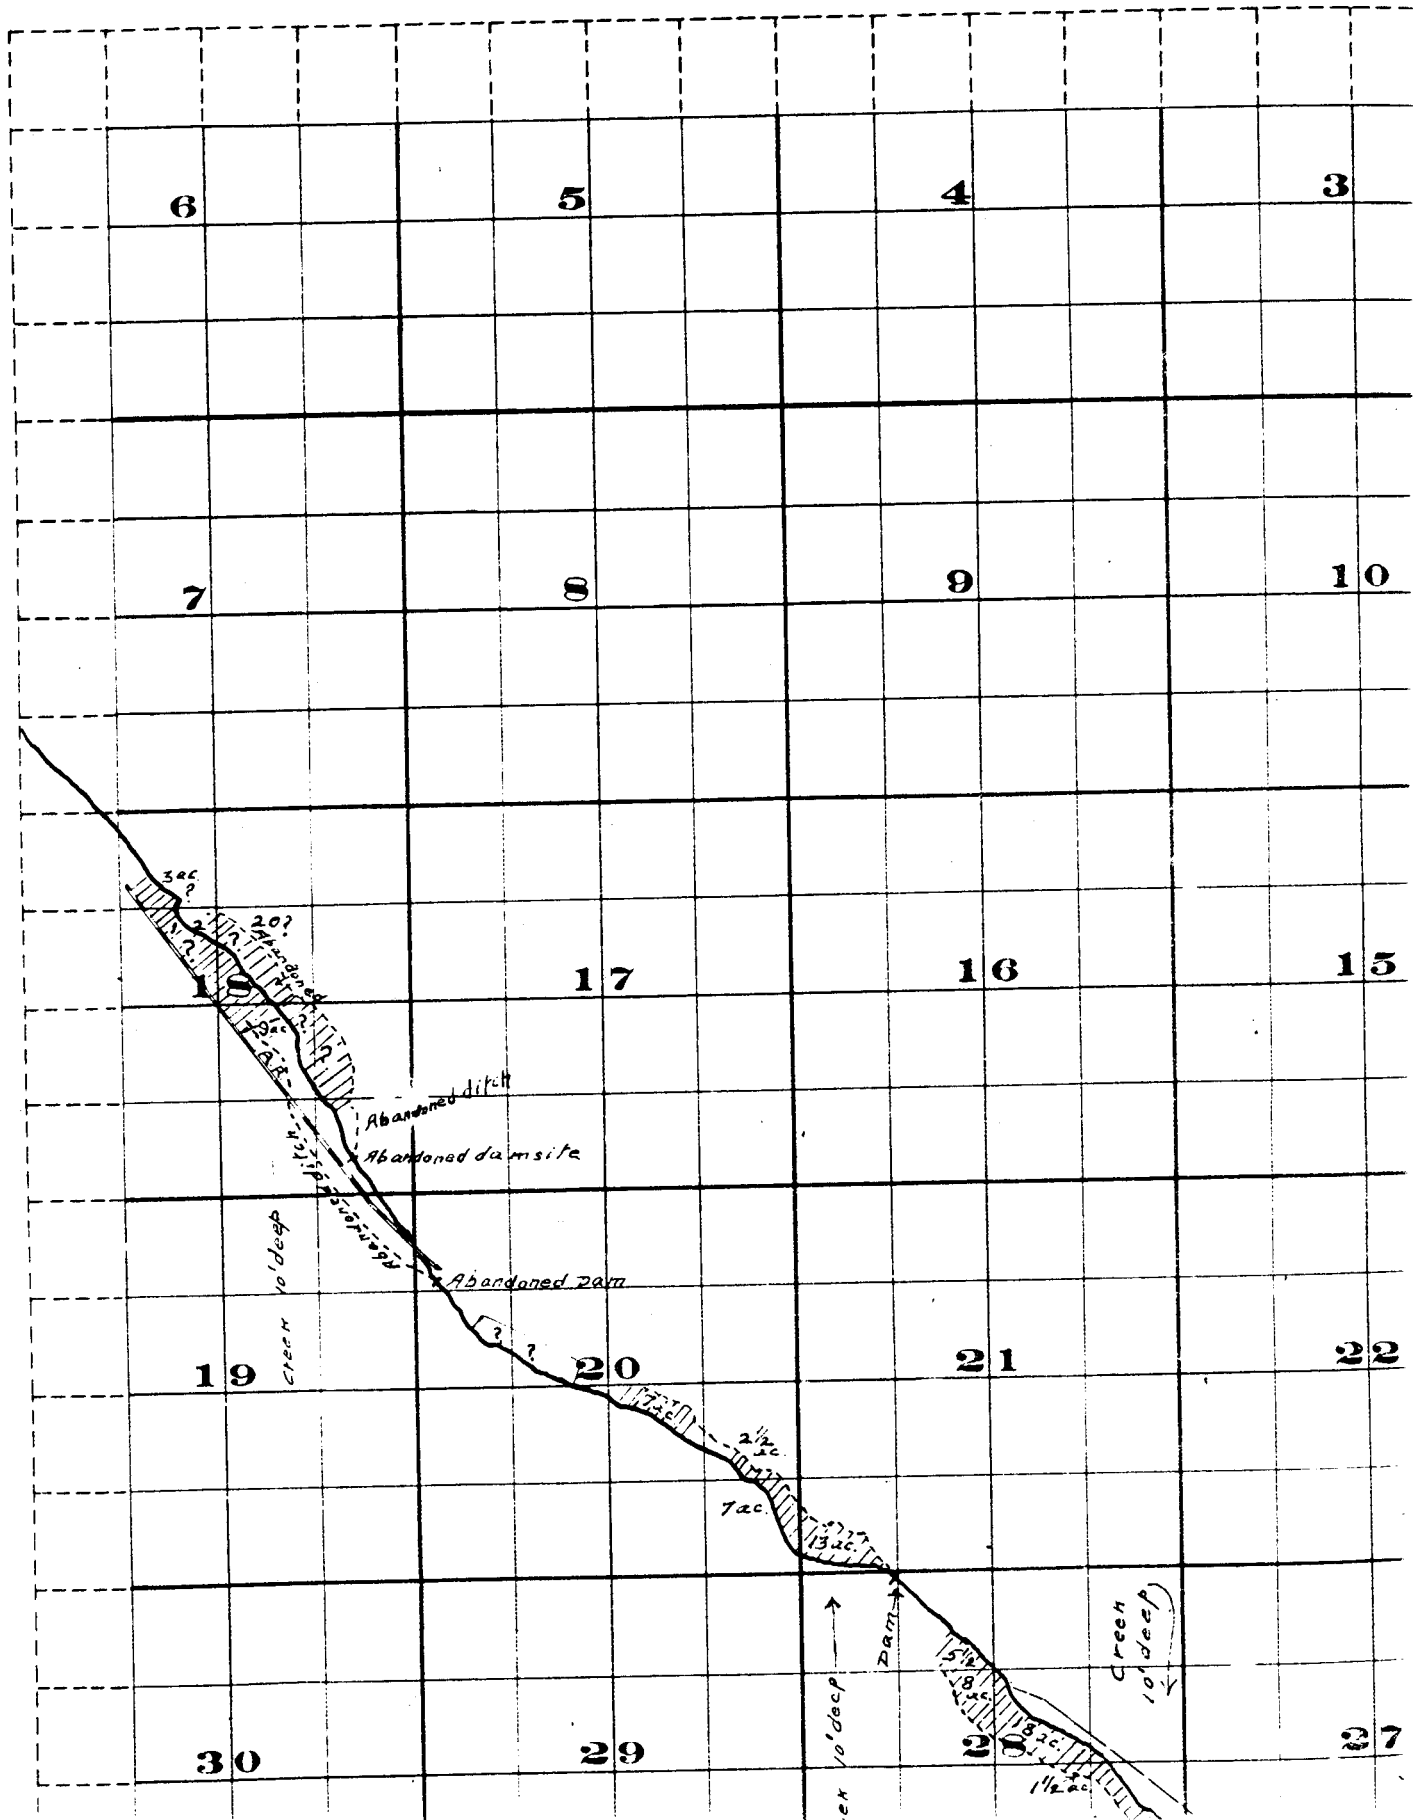

Township 1 S. , R:

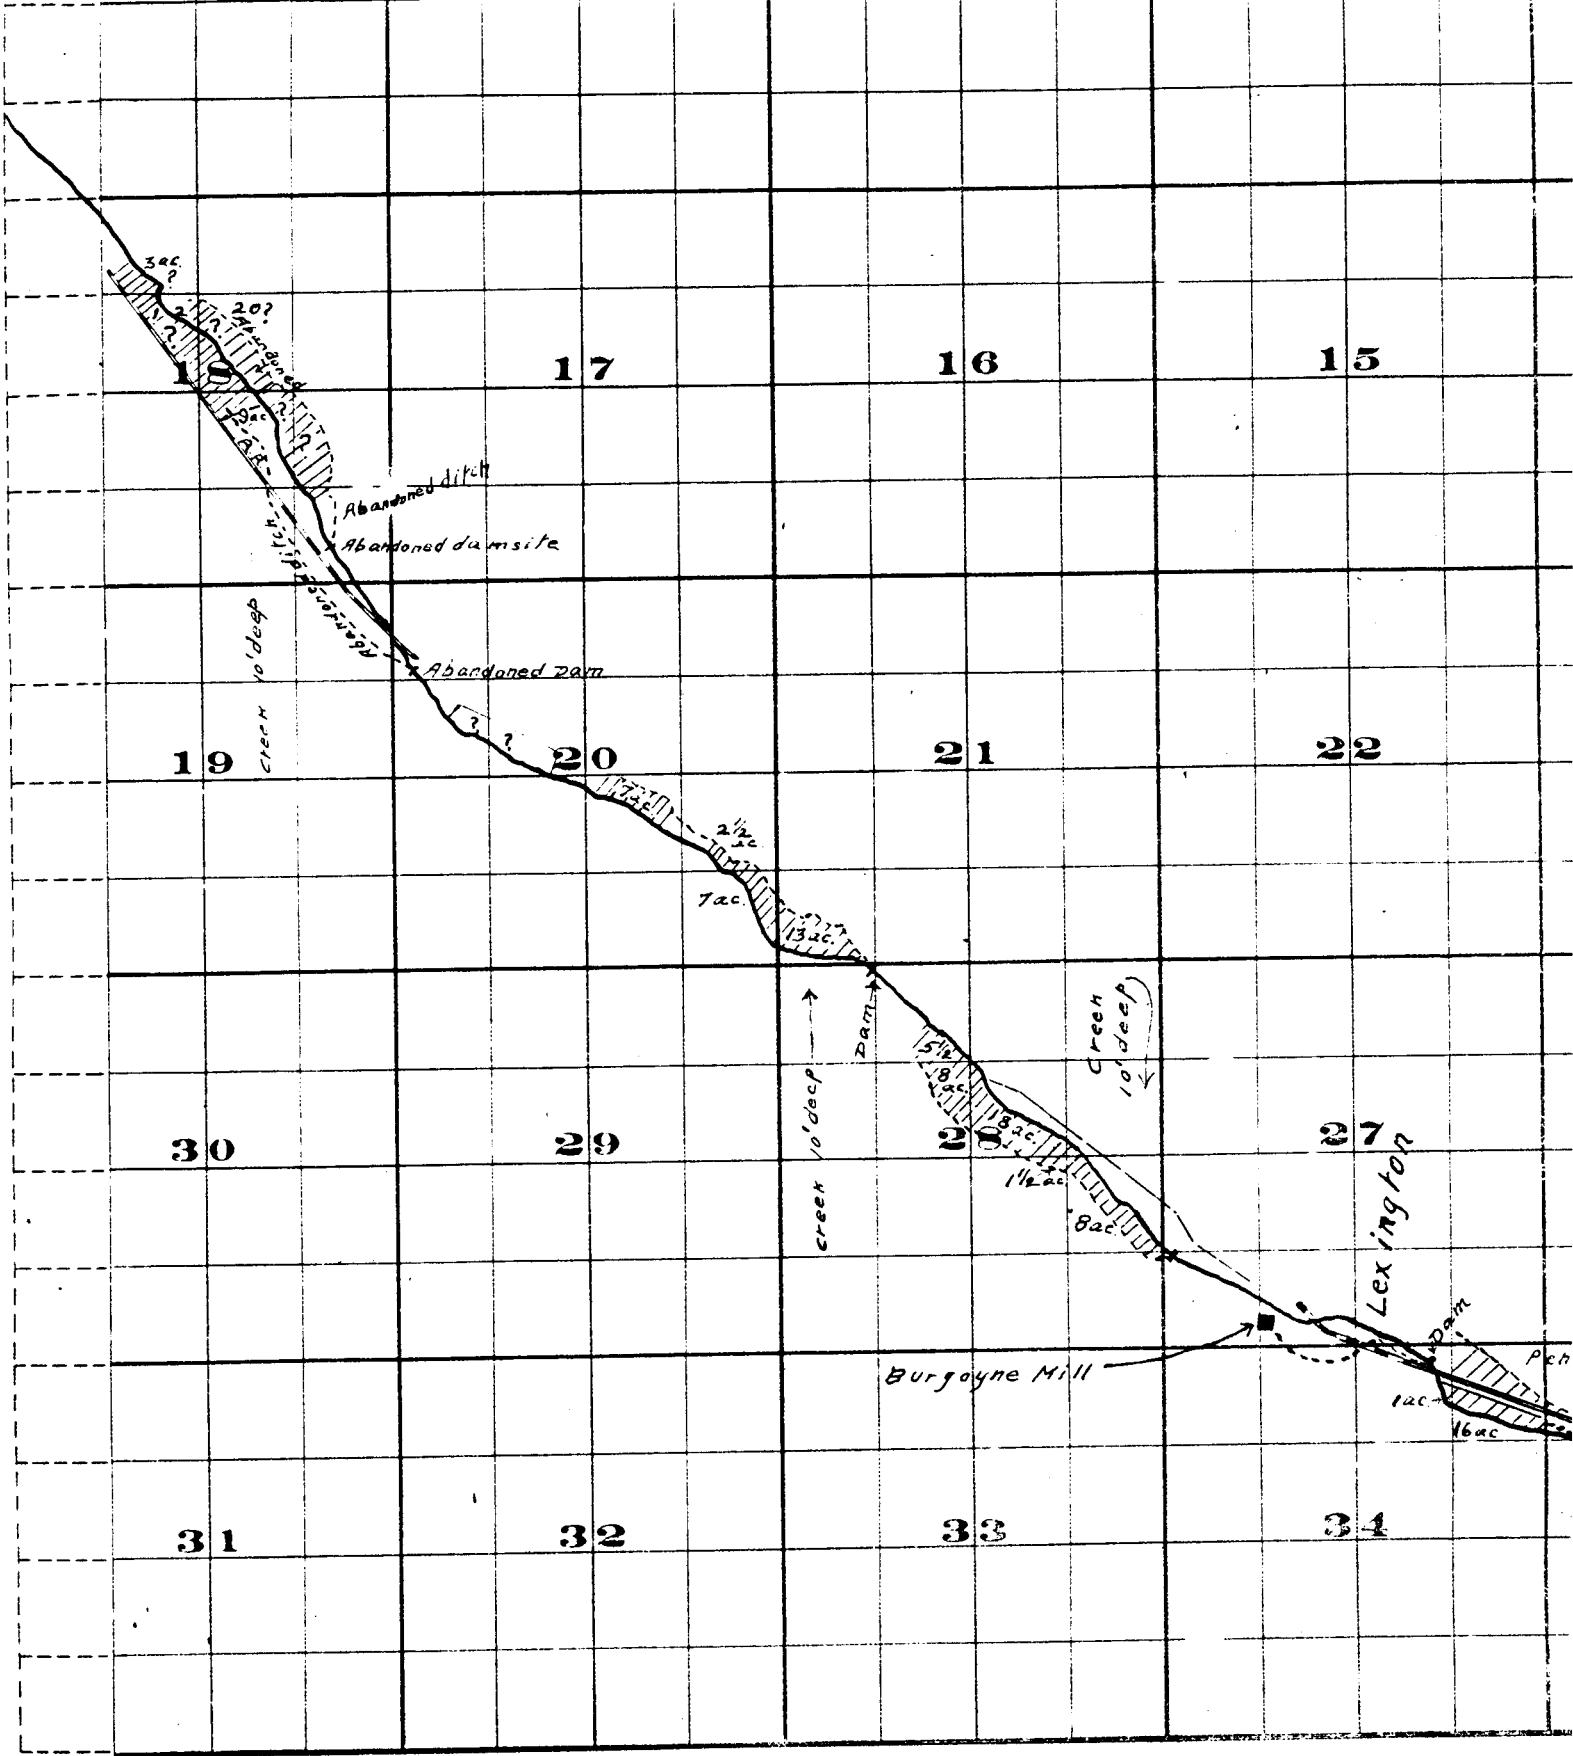




THIS IS A HISTORICAL CO. PRINTERS & BOOKBINDER, 117 N. 4TH ST.,

Surveyed by R.D. Cooper - July 1909

John H. Lewis - State Engineer

Examined July 14, 1909.

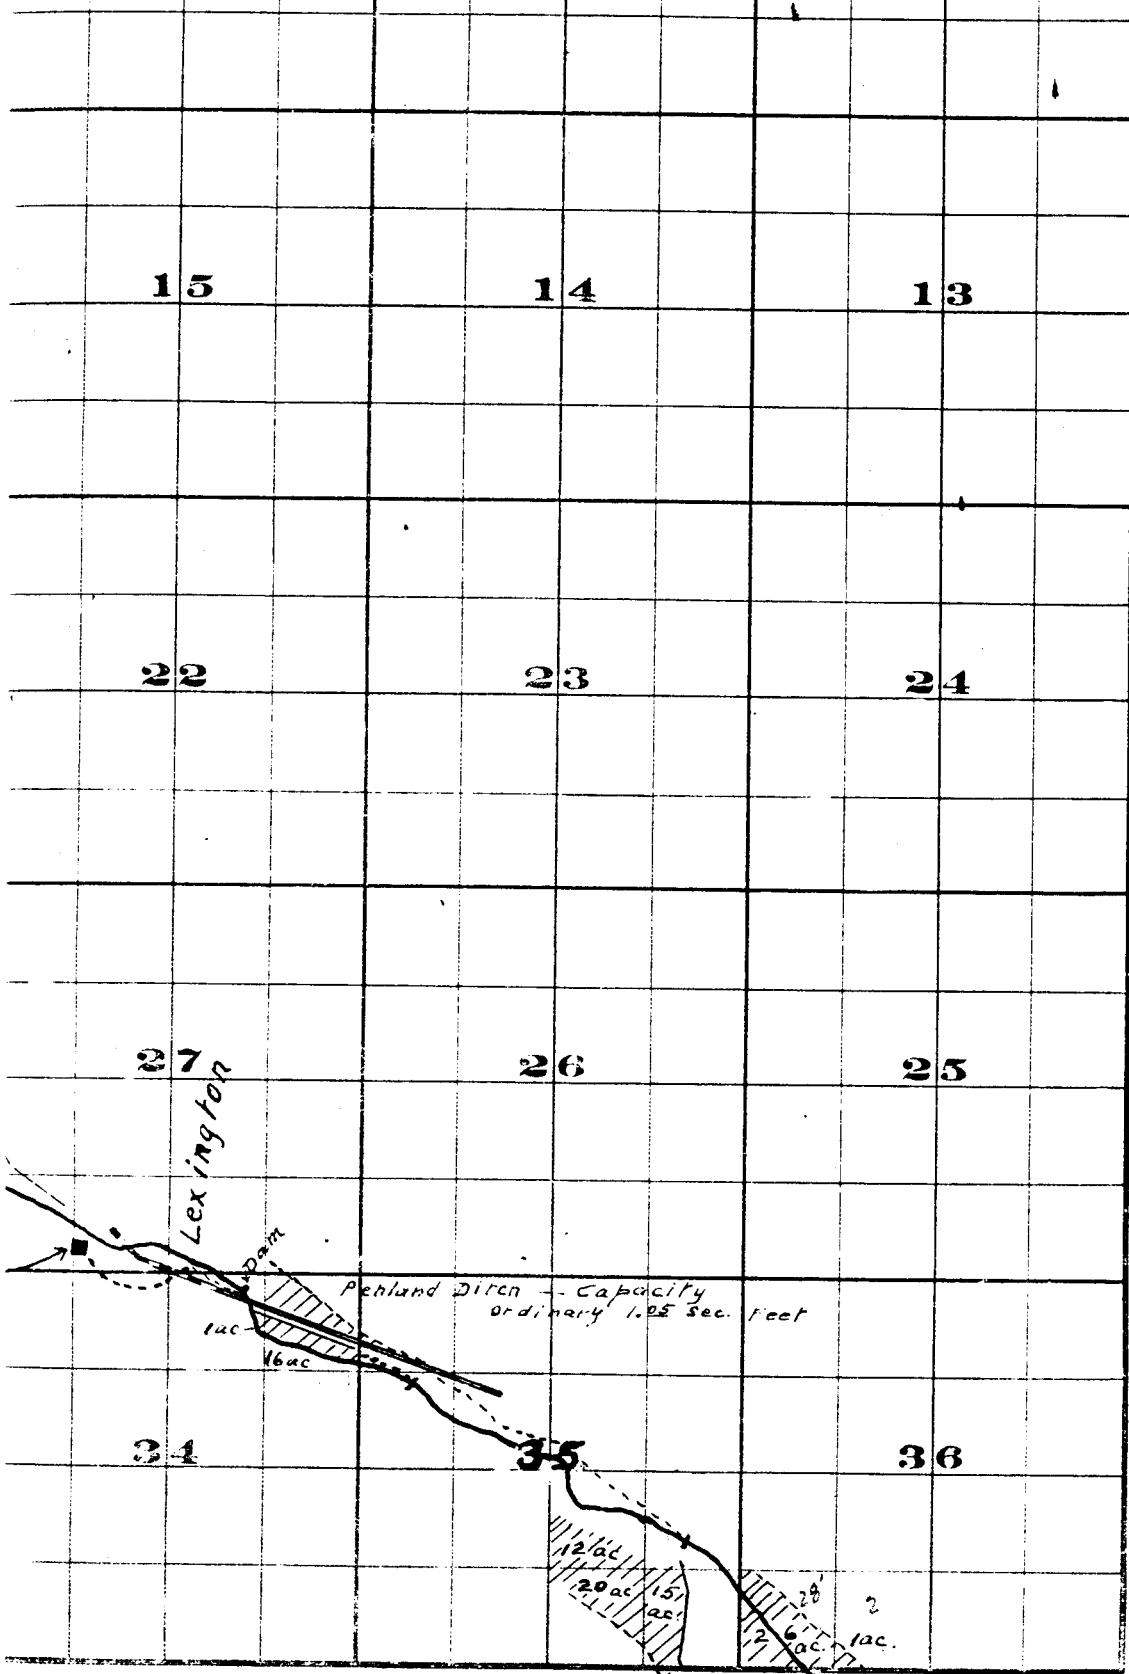

FROM OFFICE OF THE STATE ENGINEER, SALEM, OREGON

*Willow Creek Adjudication.*