


App 15535  
Per 11416  
12

11

14

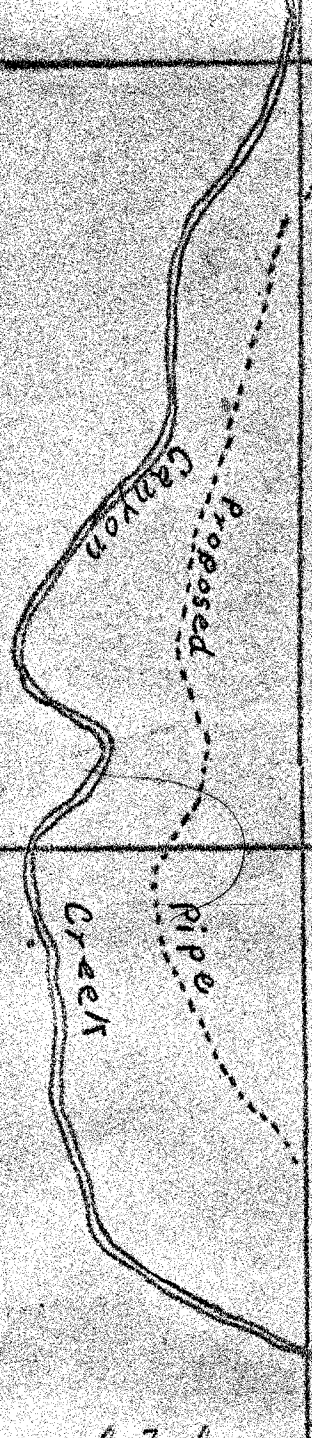

~~From~~  
~~Point of diversion~~  
~~to~~  
~~Point~~

State of Oregon }  
County of Grant } 55  
I, J. M. Blank, of Canyon City, Grant  
County, Oregon, do hereby certify that the  
aforesaid map, showing the point of div-  
ersion, general course of pipe line and  
reservoir, when water is made  
available for municipal purposes is  
a true and correct tracing from  
the maps of the State Engineer, com-  
piled in 1925, in the matter of the  
adjudication of the waters of the  
John Day River and its tributaries  
J. M. Blank

Surveyed Sept 26 1925

J. A. B. Johnson

02

~~EXAMINED BY~~

EXPENSE  
02

Point of diversion

24 as noted corrected  
on map sent with proof  
P. of div.

CANYON CITY  
2 See city map

Reservoir 1

App 15535  
Per 11416  
12

Canyon

Creek

Proposed

Pipe

Line

*[Handwritten signature]*  
13  
*[Handwritten signature]*

State of Oregon }  
County of Grant } 55

I, J. M. Blank, of Canyon City, Grant  
County, Oregon, do hereby certify that the

accompanying map, showing the point of dis-  
tension, general course of pipe line and  
reservoir, whose water is made  
available for municipal purposes in Canyon

Surveyed Sept 26 1925

J. B. [Signature]

D. J. [Signature]

02